

FEB 24 2000

SECTION

LAND CORNER RECORDATION CERTIFICATE
FILING REQUIREMENT OF ACT 74, Mich. P.A. 1970

For corners in Osceola Located in: Corner Code#
1. Public Land Survey T 20 N R 10 W A-9
2. Property Controlling in Section S T R
3. Miscellaneous Property in Sec. S T R
4. Lot No. Recorded Plat
5. Private Claims

OSCEOLA COUNTY REGISTER OF DEEDS
99 DEC 23 PM 4: 22
Register of Deeds Stamp & File Number

I, Robert L. Wetherell, in a field survey on October 1, 1999, do hereby certify that under requirements of P.A. 74, Michigan P.A. of 1970, the corner points mentioned in lines 1 and 2 above were in conformance with regulations and rules therefore as required in the current manual of survey instructions of the United States Department of the Interior, Bureau of Land Management or by decree of a Court of Law and/or that the corner points mentioned in lines 3, 4, and 5 above were in conformance with the rules of the Michigan Board of Land Surveyors or by a Decree Of a Court of Law; established, re-established, monumented, re-monumented, recovered, found as expressed below:

Table with 13 rows and 13 columns labeled A through M. Contains numbers 1 through 36 in a grid pattern.

A-9 - Section corner common to Sections 19 & 30, T20N, R10W, Osceola Co., Mi.

A. Description of original monument and accessories and/or subsequent restoration:

1838 - S. Sibley, G.L.O.

- #1 - 8" Beech S59°W 25 Links
#2 - 6" Beech N81°W 25 Links

1919 - G. Johnson, Lake Co. Sur.

- #3 - 18" Maple N10°E 179'
"4-1/2 feet of fill on top of stake".

1998 - M. McClung, LS 13037

- Surveys recorded Lake County L. 4, Pg. 278 & L. 4, Pg. 280. Found 2 re-rods on top of each other. Set Osceola County Monument.
#4 - P. Pole N40°W 109.3'
#5 - 16" W. Pine N40°E 65.55'
#6 - R/W marker S50°E 55.9'
#7 - P. Pole S20°W 176.3'
1/2 Mile South 2646.04'
Mile South 5291.55'

1905 - Burdell Twp. Book

- Pages 16 & 17
1/2 Mile South 2644'
Mile South 5291'

B. Description of corner evidence found and/or method applied in restoring or reestablishing corner:

I found the Osceola County Monument 6 feet more or less North of centerline of a East and West road and in the centerline of a North and South Road. I measured 2640.55 feet North to the 1/4 corner.

Condition of the accessories are as follows: #1 Gone, #2 Gone, #3 Found in good condition (40" N15°E 178' m/l), #4 Found in good condition, #5 Found in good condition, #6 Gone, #7 Found in good condition

C. Description of monument for corner and accessories established to perpetuate locating the position of the corner:

I accepted the Osceola County Monument (1-1/2" pipe with an Osceola County Remon Cap) as a substantial marker of the corner and is accepted as a careful and faithful reestablishment of the position of the original corner.

- Power Pole N40°W 109.3' (Nail on N.E. side) #4
16" W. Pine N40°E 65.55' (Nail on N.W. side) #5
Right of way marker S50°E 55.9' ("X" chiseled on top) #6
Power Pole S20°W 176.3' (Nail on N.W. side) #7


Signed by Robert L. Wetherell Date 12/16/99

Surveyor's Michigan License No. 24624

APPROVED LAND CORNER
P.A. 345 OF 1990
Osceola County

12-9-99
R.L.W.

LIBER B PAGE 584

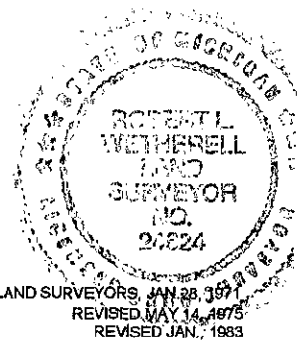

FORM APPROVED BY MICHIGAN STATE BOARD OF LAND SURVEYORS, JAN 28, 1971
REVISED MAY 14, 1975
REVISED JAN., 1983