

FEB 24 2000

LAND CORNER RECORDATION CERTIFICATE

FILING REQUIREMENT OF ACT 74, Mich. P.A. 1970

SECTION

For corners in <u>Osceola</u>	Located in:	Corner Code#
1. Public Land Survey	T 20N R 10W	A-11
	T R	
	T R	
	T R	
2. Property Controlling s in Section	T R	
	S T R	
3. Miscellaneous Property in Sec.	S T R	
	S T R	
4. Lot No. _____ Recorded Plat		
5. Private Claims		

OSCEOLA COUNTY
 REGISTER OF DEEDS
 99 NOV 19 PM 12:11
Mary Campbell

Register of Deeds Stamp & File Number

	A	B	C	D	E	F	G	H	I	J	K	L	M
1													
2	6	5	4	3	2	1							
3													
4	7	8	9	10	11	12							
5													
6	18	17	16	15	14	13							
7													
8	19	20	21	22	23	24							
9													
10	30	29	28	27	26	25							
11													
12	31	32	33	34	35	36							
13													

I, Robert L. Wetherell, in a field survey on October 1 1999, do hereby certify that under requirements of P.A. 74, Michigan P.A. of 1970, the corner points mentioned in lines 1 and 2 above were in conformance with regulations and rules therefore as required in the current manual of survey instructions of the United States Department of the Interior, Bureau of Land Management or by decree of a Court of Law and/or that the corner points mentioned in lines 3, 4, and 5 above were in conformance with the rules of the Michigan Board of Land Surveyors or by a Decree Of a Court of Law; established, re-established, monumented, re-monumented, recovered, found as expressed below:

NOTE: ONLY ONE CORNER MAY BE RECORDED ON THIS CERTIFICATE.

Corner Common to Sec's 30 & 31 on County Line

A. Description of original monument and accessories and/or subsequent restoration:

- | | | |
|--|--|---|
| <p><u>1838 S. Sibley</u>
 #1-16" Hemlock N34W 7 lk.
 #2- 16" Beech S41W 42 Lk.</p> | <p><u>1905 Bardell Twp Book</u>
 Pages 12,13,14,15,16 & 17
 Iron Grate & Crook
 #3- 2" Maple N12 1/2 W 100 Lks
 Dist. North 2649.24'
 Dist. East 2959.44'
 Mile North 5291.'
 Note: GLO Dist East 2451.24'</p> | <p><u>1998 M. McClung LS 13037</u>
 Recorded Surveys-Lake County
 L. 4, Pg. 278
 L. 4, Pg. 280
 Fd. 3/4" Iron Grate & Crockery
 Set Osceola Co. Monument
 #4- 7" E. Maple clump of 3
 (Nail in NE side) N34W 71.6'
 #5 - P. Pole (Nail in SW side) S35W 99.8'
 #6 - 22" Maple (Nail in S. side) East 75.9'
 #7 - Cut off P. Pole (Nail in NW side) S28W 97.4'
 Dist. East 2817.59'
 Dist North 2645.51'</p> |
|--|--|---|

B. Description of corner evidence found and/or method applied in restoring or reestablishing corner:

I found Osceola County Monument in the C/L of a road North and South and +/- 3' South of the C/L of the road West.

Condition of the accessories are as follow: #1 Gone, #2 Gone, #3 Gone, #4 Found in good condition, #5 Found in good condition, #6 Found in good condition and #7 Found in good condition.

C. Description of monument for corner and accessories established to perpetuate locating the position of the corner:


I accept the Osceola County Monument (1 1/2" pipe with an Osceola County Remon Cap) as a substantial marker of the corner and is accepted as a careful and faithful reestablishment of the position of the original corner.

- 7" Maple (in clump) N34W 71.6' (Nail in NE side) - #4
- P. Pole S35W 99.8' (Nail in SW side) - #5
- 22" Maple East 75.9' (Nail in S side) - #6
- Cut off P. Pole S28W 97.4' (Nail in NW side) - #7

Signed by Robert L. Wetherell

Date Nov. 9,

Surveyor's Michigan License No. 24624

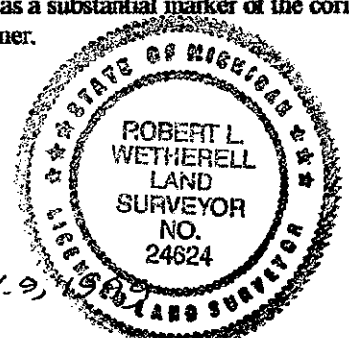

APPROVED LAND CORNER
 P.A. 345 OF 1990
 Osceola County

10-21-99
R L W.

FORM APPROVED BY MICHIGAN STATE BOARD OF LAND SURVEYORS, JAN 28, 1971
 REVISED MAY 14, 1975
 REVISED JAN., 1983
 ADAPTED FOR WORD PROCESSING JANUARY, 1989