

SURVEY & REMONUMENTATION

SEP 15 1994

COMMISSION

LAND CORNER RECORDATION CERTIFICATE
Filing Requirement of Act 74, Mich. P.A. 1970

LIBER A PAGE 182

For corners in

Osceola

(County)

Located In:

Corner Code #

20N 10W

E-9

- | | | | | | |
|------------------------------------|---|-------|---|-------|-------|
| 1. Public Land Survey | T | _____ | R | _____ | _____ |
| | T | _____ | R | _____ | _____ |
| | T | _____ | R | _____ | _____ |
| | T | _____ | R | _____ | _____ |
| 2. Property Controlling in Section | S | _____ | T | _____ | R |
| | S | _____ | T | _____ | R |
| 3. Miscellaneous Property in Sec. | S | _____ | T | _____ | R |
| | S | _____ | T | _____ | R |

APPROVED LAND CORNER
P.A. 345 OF 1990
Osceola County

Matthew McClung
 21 June 1994

Register of Deeds Stamp & File Number

4. Lot No. _____, Recorded Plat _____
 5. Private Claims _____

Matthew McClung

June 8, 94

I, _____, in a field survey on _____, 19_____, do hereby certify that under requirements of P.A. 74, Michigan P.A. of 1970, the corner points mentioned in lines 1 and 2 above were in conformance with regulations and rules therefore as required in the current manual of survey instructions of the United States Department of the Interior, Bureau of Land Management or by a decree of a Court of Law and/or that the corner points mentioned in lines 3, 4 and 5 above were in conformance with the rules of the Michigan Board of Land Surveyors or by a Decree of a Court of Law; established, re-established, monumented, re-monumented, recovered, found as expressed below:

NOTE: Not more than 4 corners, all in the same town and range, may be recorded on this certificate.

	A	B	C	D	E	F	G	H	I	J	K	L	M
2	6	5	4	3	2	1							
3													
4	7	8	9	10	11	12							
5													
6	18	17	16	15	14	13							
7													
8	19	20	21	22	23	24							
9													
10	30	29	28	27	26	25							
11													
12	31	32	33	34	35	36							
13													

A. Description of original monument and accessories and/or subsequent restoration:

The original corner was set by deputy surveyor Sylvester Sibley on 7 July 1838. Set wood post 80.00 chains from South.


Beech 12" S10E 44 lks.

Beech 9" N14W 32 lks.

This corner is recorded in the Burdell Twp. Book, pages 6 & 7 and pages 26 & 27 as rod on gas pipe. Also PA 132 by McClung.

B. Description of corner evidence found and/or method applied in restoring or reestablishing corner:

Found 1/2" rod 5" below road surface. Found 1 1/2" Pipe 14" below road surface. I could not fit Osceola County Monument into pipe, set monument leaning to east so top of monument is over center of pipe. Monument is 6" below road surface and 3 feet West of centerline.

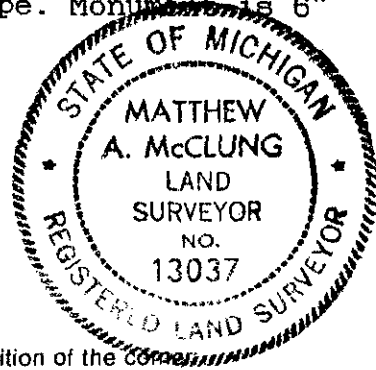

C. Description of monument for corner and accessories established to perpetuate locating the position of the corner:

Corner E-8. Osceola County Monument, which is a 3" brass cap mounted on a 1" pipe 18" in length.

Power Pole S25W 118.70 feet OBM.

Power Pole S20E 108.45 feet.

16" Elm N82W 43.5 feet.

"I" beam guard rail post N25W 29.95 feet.

Nancy Crawford
 84 AUG 19 PM 3:29
 OSCEOLA COUNTY REGISTER OF DEEDS

Signed by *Matthew McClung*

Date June 8, 1994

Surveyor's Michigan License No. 13037