

AUG 23 1995

COMMISSION

LAND CORNER RECORDATION CERTIFICATE
Filing Requirement of Act 74, Mich. P.A. 1970

For corners in

<u>Osceola</u> (County)	Located In:	Corner Code #
	20N 10W	G-10
1. Public Land Survey	T ___ R ___	_____
	T ___ R ___	_____
	T ___ R ___	_____
	T ___ R ___	_____
2. Property Controlling in Section	S ___ T ___ R ___	_____
	S ___ T ___ R ___	_____
3. Miscellaneous Property in Sec.	S ___ T ___ R ___	_____
	S ___ T ___ R ___	_____
4. Lot No. _____, Recorded Plat _____		
5. Private Claims _____		

APPROVED LAND CORNER
P.A. 345 OF 1990
Osceola County

Matthew McClung
August 3, 1995

Register of Deeds Stamp & File Number

Matthew McClung July 26, 1995

I, _____, in a field survey on _____, 19____, do hereby certify that under requirements of P.A. 74, Michigan P.A. of 1970, the corner points mentioned in lines 1 and 2 above were in conformance with regulations and rules therefore as required in the current manual of survey instructions of the United States Department of the Interior, Bureau of Land Management or by a decree of a Court of Law and/or that the corner points mentioned in lines 3, 4 and 5 above were in conformance with the rules of the Michigan Board of Land Surveyors or by a Decree of a Court of Law; established, re-established, monumented, re-monumented, recovered, found as expressed below:

NOTE: Not more than 4 corners, all in the same town and range, may be recorded on this certificate.

A. Description of original monument and accessories and/or subsequent restoration:

The original corner was set by deputy surveyor Sylvester Sibley on 7 July 1838. Set wood post 40 chains from South.
Beech 12" N37E 36 lks.
Beech 12" S12W 18 lks.

This corner is recorded in the Burdell Twp. Book, pages 72 and 73.

I have shown 1 LCRC certificate by Ray.

I have shown 2 PA 132 Surveys 1 by McClung and 1 by Erickson.

B. Description of corner evidence found and/or method applied in restoring or reestablishing corner:


Found 1/2" re-rod at surface. Found drive shaft at 18" below surface. set Osceola County Monument over center of drive shaft, 6" below surface. Mr. Ray Calls for Axle shaft, and the corner is a drive shaft.

C. Description of monument for corner and accessories established to perpetuate locating the position of the corner:

Corner G-10. Osceola County Monument, which is a 3" brass cap mounted on a 1" pipe 18" in length.
Stub Telephone Pole S25W 49.28 feet. O.B.P.
Power Pole N86E 77.02 feet.
7" End N Pine N68E 53.56 feet.
9" S. Pine N26W 88.10 feet.

A	B	C	D	E	F	G	H	I	J	K	L	M
2	6	5	4	3	2	1						
3												
4	7	8	9	10	11	12						
5												
6	18	17	16	15	14	13						
7												
8	19	20	21	22	23	24						
9												
10	30	29	28	27	26	25						
11												
12	31	32	33	34	35	36						
13												

Yancy Campbell
95 AUG -9 PM 12:12
OSCEOLA COUNTY
REGISTER OF DEEDS

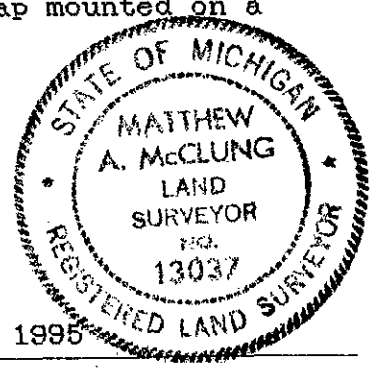

Signed by *Matthew McClung* Date July 26, 1995
Surveyor's Michigan License No. 13037