

SURVEY & REMONUMENTATION

AUG 28 1995

COMMISSION

LAND CORNER RECORDATION CERTIFICATE
Filing Requirement of Act 74, Mich. P.A. 1970

For corners in
Osceola
(County)

Located In: 20N 10W Corner Code G-11

1. Public Land Survey	T	R	
	T	R	
	T	R	
	T	R	
2. Property Controlling in Section	S	T	R
	S	T	R
3. Miscellaneous Property in Sec.	S	T	R
	S	T	R

APPROVED LAND CORNER
P.A. 345 OF 1990
Osceola County

Matthew McClung
August 3, 1995

Register of Deeds Stamp & File Number

4. Lot No. _____, Recorded Plat _____
5. Private Claims _____

Matthew McClung July 26, 1995

I, _____, in a field survey on _____, 19____, do hereby certify that under requirements of P.A. 74, Michigan P.A. of 1970, the corner points mentioned in lines 1 and 2 above were in conformance with regulations and rules therefore as required in the current manual of survey instructions of the United States Department of the Interior, Bureau of Land Management or by a decree of a Court of Law and/or that the corner points mentioned in lines 3, 4 and 5 above were in conformance with the rules of the Michigan Board of Land Surveyors or by a Decree of a Court of Law; established, re-established, monumented, re-monumented, recovered, found as expressed below:

A	B	C	D	E	F	G	H	I	J	K	L	M
2	6	5	4	3	2	1						
3												
4	7	8	9	10	11	12						
5												
6	18	17	16	15	14	13						
7												
8	19	20	21	22	23	24						
9												
10	30	29	28	27	26	25						
11												
12	31	32	33	34	35	36						
13												

NOTE: Not more than 4 corners, all in the same town and range, may be recorded on this certificate.

A. Description of original monument and accessories and/or subsequent restoration:

The original corner was set by deputy surveyor Sylvester Sibley on 7 July 1838. Set wood post 80 chains from South.
Pine 26" N71E 14 lks.
Hemlock 9" S56W 16 lks.

This corner is recorded in the Burdell Twp. Book, pages 72 and 73.

I have shown 1 LCRC certificate by Ray.

I have shown 1 PA 132 Survey by McClung.


B. Description of corner evidence found and/or method applied in restoring or reestablishing corner:

Found 1/2" rod and 1" angle iron 3" below surface. Removed both rod and angle iron and set Osceola County Monument 6" below surface. Old corner fence post to East. The 2 Pine tree witnesses below, are consistent with the unrecorded Taylor survey.

Janey Crawford
OSCEOLA COUNTY
REGISTER OF DEEDS
95 AUG -9 PM 12: 12

C. Description of monument for corner and accessories established to perpetuate locating the position of the corner:

Corner G-11. Osceola County Monument, which is a 3" brass cap mounted on a 1" pipe 18" in length.
6" Red Oak N34E 41.7 feet.
Iron and Cap West 33.0 feet.
22" W. Pine S70E 29.80 feet. OBT
22" W. Pine East 27.3 feet. OBT

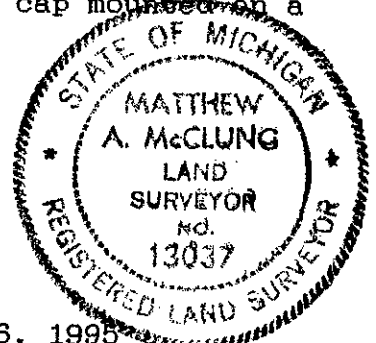

Signed by *Matthew McClung* Date July 26, 1995
Surveyor's Michigan License No. 13037

FORM APPROVED BY MICHIGAN STATE BOARD OF LAND SURVEYORS, JAN. 28, 1971
REVISED MAY 14, 1975
REVISED JAN., 1983