

SURVEY & REMONUMENTATION

FEB 12 1998

LAND CORNER RECORDATION CERTIFICATE Filing Requirement of Act 74, Mich. P.A. 1970

For corners in SECTION
Osceola
(County)

Located In: _____ Corner Code # _____

- | | | |
|------------------------------------|-------------------------|-------|
| 1. Public Land Survey | T <u>20N</u> 7W | D-6 |
| | T _____ R _____ | _____ |
| | T _____ R _____ | _____ |
| | T _____ R _____ | _____ |
| 2. Property Controlling in Section | S _____ T _____ R _____ | _____ |
| | S _____ T _____ R _____ | _____ |
| 3. Miscellaneous Property in Sec. | S _____ T _____ R _____ | _____ |
| | S _____ T _____ R _____ | _____ |

APPROVED LAND CORNER
P.A. 345 OF 1990
Osceola County

Matthew McClung
24 July 1997

Register of Deeds Stamp & File Number

4. Lot No. _____, Recorded Plat _____
5. Private Claims _____

I, Matthew McClung, in a field survey on 07-8, 19 97 do hereby state that under requirements of P.A. 74, Michigan P.A. of 1970, the corner points mentioned in lines 1 and 2 above were in conformance with regulations and rules therefore as required in the current manual of survey instructions of the United States Department of the Interior, Bureau of Land Management or by a decree of a Court of Law and /or that the corner points mentioned in lines 3, 4 and 5 above were in conformance with the rules of the Michigan Board of Land Surveyors or by a Decree of a Court of Law, established, re-established, monumented, recovered, found as expressed below:

NOTE: Not more than 2 corners, all in the same town and range, may be recorded on this certificate.

	A	B	C	D	E	F	G	H	I	J	K	L	M
1													
2	6		5		4		3		2		1		
3													
4	7		8		9		10		11		12		
5													
6	18				16		15		14		13		
7													
8	19		20		21		22		23		24		
9													
10	30		29		28		27		26		25		
11													
12	31		32		33		34		35		36		
13													

A. Description of original monument and accessories and/or subsequent restoration:

Marion Township Record Book	PA 74
No Date	Liber 1, Page 306
Set Wagon Axle	Dated: 4 June 1974 by McClung
Elm 5" N48W 46.0 feet.	Found Iron
Apple 4" N22E 47. feet.	8" Cherry S35E 13.2 feet
	16" Maple N25E 32.1 feet
	24" Cherry N50E 52.50 feet

continued on back


B. Description of corner evidence found and/or method applied in restoring or reestablishing corner:

Found Osceola County Monument 9" above ground surface.

C. Description of monument for corner and accessories established to perpetuate locating the position of the corner:

Corner D-6. Osceola County Monument, which is a 3" brass cap mounted 1" pipe 24" in length.

- 24" Maple N30E 32.9 feet.
- 18" Twin Cherry N60E 54.0 feet.
- 14" Cherry S50E 13.45 feet.
- 18" Cherry N75W 59.75 feet.

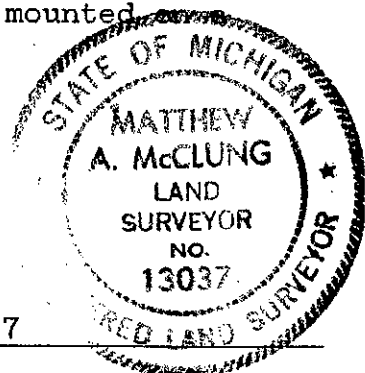

Signed by *Matthew McClung*
Surveyor's Michigan License No. 13037

Date July 8 1997

OSCEOLA COUNTY
REGISTER OF DEEDS

97 AUG -7 AM 11:53

Nancy Crawford

PA 74

Liber 3, Page 92

Dated: 17 July 1984 by McClung

Found Wagon Axle

24" Maple N30E 32.9 feet.

18" Twin Cherry N60E 54. feet.

14" Cherry S50E 13.45 feet

18" Cherry N75W 59.75 feet.

**SURVEY &
REMONUMENTATION**

FEB 12 1998

SECTION