

**SURVEY & REMONUMENTATION**

**FEB 12 1998**

**LAND CORNER RECORDATION CERTIFICATE**  
**Filing Requirement of Act 74, Mich. P.A. 1970**

**SECTION**  
 For corners in  
Osceola  
 (County)

Located in: Corner Code #

1. Public Land Survey	T <u>20NR 7W</u>	<u>E-6</u>
	T ___ R ___	_____
	T ___ R ___	_____
	T ___ R ___	_____
2. Property Controlling in Section	S ___ T ___ R ___	_____
	S ___ T ___ R ___	_____
3. Miscellaneous Property in Sec.	S ___ T ___ R ___	_____
	S ___ T ___ R ___	_____

**APPROVED LAND CORNER**  
 P.A. 345 OF 1990  
 Osceola County  
*24 July 1997*  
*Matthew McClung*  
**Register of Deeds Stamp & File Number**

4. Lot No. \_\_\_\_\_, Recorded Plat \_\_\_\_\_  
 5. Private Claims \_\_\_\_\_

I, Matthew McClung, in a field survey on July 29 97 do hereby state that under requirements of P.A. 74, Michigan P.A. of 1970, the corner points mentioned in lines 1 and 2 above were in conformance with regulations and rules therefore as required in the current manual of survey instructions of the United States Department of the Interior, Bureau of Land Management or by a decree of a Court of Law and /or that the corner points mentioned in lines 3, 4 and 5 above were in conformance with the rules of the Michigan Board of Land Surveyors or by a Decree of a Court of Law; established, re-established, monumented, recovered, found as expressed below:


	A	B	C	D	E	F	G	H	I	J	K	L	M
1													
2	6		5		4		3		2		1		
3													
4	7		8		9		10		11		12		
5													
6	18		17		16		15		14		13		
7													
8	19		20		21		22		23		24		
9													
10	30		29		28		27		26		25		
11													
12	31		32		33		34		35		36		
13													

NOTE: Not more than 2 corners, all in the same town and range, may be recorded on this certificate.

A. Description of original monument and accessories and/or subsequent restoration:  
 The original corner was set by deputy surveyor Frances Coleman on April 29, 1856. Set wood post 40.00 chains from the North.  
 Hemlock 18" N52W 33 lks.  
 Hemlock 9" S42 1/2E 41 lks.  
 From 1891 to 1904 approximately, Osceola County had a remonumentation program, in which surveyors Temple and Trumbull, did the work. For the most part, a 3" glazed tile filled with cinders from a forge, were placed at each government set corner in the township. There were supposed to be 3 tile per corner, placed atop of each other, (continued on back)

B. Description of corner evidence found and/or method applied in restoring or reestablishing corner:  
 Found Osceola County Monument in center of tile in water Hole. Placed 3" Sapling Stake on West side of tile and iron. Sapling stake sticks up above water approximately 2 to 3 feet.

C. Description of monument for corner and accessories established to perpetuate locating the position of the corner:  
 Corner E-6. Osceola County Monument, which is a 3" brass cap mounted on a 1" pipe 18" in length.  
 7" Maple S53E 31.5 feet.  
 6" Cherry S15E 42.5 feet.  
 10 Maple S80W 26.4 feet.  
 16" Maple N35W 24.0 feet.

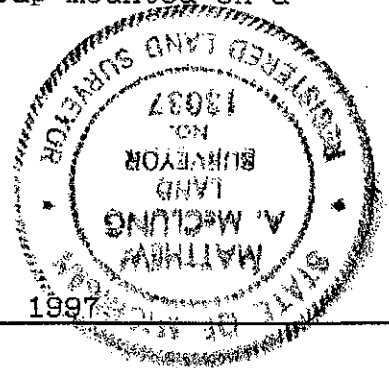

Signed by Matthew McClung  
 Surveyor's Michigan License No. 13037

Date July 2 1997

thereby making the corner 4 feet long. Sometimes a solid tile, with a cross in the top was used, and sometimes a 1/2" iron bars were added to the tile. Notes of the work were kept in ledgers, and given to the townships, and 5 of the townships have been entered in the County Surveyors records.

PA 74  
Liber 3, Page 92  
Dated: 17 July 1984 by McClung  
Found Tile  
7" Maple S53E 31.5 feet.  
6" Cherry S15E 42.5 feet  
10" Maple S80W 26.4 feet.  
16" Maple N35W 24.0 feet.

Marion Township Records Book  
Found tile  
Pine 24" S53E 29'  
Hem 21" N54E 29'

*James Crawford*  
97 AUG - 7 AM 11:54  
OSCEOLA COUNTY  
REGISTER OF DEEDS

**SURVEY &  
REMONUMENTATION**

**FEB 12 1998**

**SECTION**