

SURVEY & REMONUMENTATION

NOV 16 1998

LAND CORNER RECORDATION CERTIFICATE
Filing Requirement of Act 74, Mich. P.A. 1970

SECTION
For corners in

<u>Osceola</u> (County)	Located In:	Corner Code #
1. Public Land Survey	T <u>20</u> N R <u>7</u> W	<u>E-8</u>
	T <u> </u> R <u> </u>	<u> </u>
	T <u> </u> R <u> </u>	<u> </u>
	T <u> </u> R <u> </u>	<u> </u>
2. Property Controlling in Section	S <u> </u> T <u> </u> R <u> </u>	<u> </u>
	S <u> </u> T <u> </u> R <u> </u>	<u> </u>
3. Miscellaneous Property in Sec.	S <u> </u> T <u> </u> R <u> </u>	<u> </u>
	S <u> </u> T <u> </u> R <u> </u>	<u> </u>

APPROVED LAND CORNER
P.A. 345 OF 1990
Osceola County
Matthew McClung
2 July 98

Register of Deeds Stamp & File Number

4. Lot No. _____, Recorded Plat _____
5. Private Claims _____


I, Matthew McClung in a field survey on 6, 23, 1998 do hereby state that under requirements of P.A. 74, Michigan P.A. of 1970, the corner points mentioned in lines 1 and 2 above were in conformance with regulations and rules therefore as required in the current manual of survey instructions of the United States Department of the Interior, Bureau of Land Management or by a decree of a Court of Law and/or that the corner points mentioned in lines 3, 4 and 5 above were in conformance with the rules of the Michigan Board of Land Surveyors or by a Decree of a Court of Law, established, re-established, monumented, recovered, found as expressed below:

NOTE: Not more than 2 corners, all in the same town and range, may be recorded on this certificate.

A	B	C	D	E	F	G	H	I	J	K	L	M
1												
2	6		5		4		3		2		1	
3												
4	7		8		9		10		11		12	
5												
6	18		17		16		15		14		13	
7												
8	19		20		21		22		23		24	
9												
10	30		29		28		27		26		25	
11												
12	31		32		33		34		35		36	
13												

A. Description of original monument and accessories and/or subsequent restoration:
The original corner was set by deputy surveyor Francis Coleman Sept. 27, 1856. Set Post 39.78 chains from South.
Elm 6" N44E 8 lks.
Sugar 10" S46 1/2W 35 lks
From 1891 to 1904 approximately, Osceola County had a remonumentation program, in which surveyors Temple and Trumbull, did the work. For the most part, a 3" glazed tile filled with cinders from a forge, were placed at each government set corner in the township. There were supposed to be 3 tile per corner, placed atop of each other, (continued on back)

B. Description of corner evidence found and/or method applied in restoring or reestablishing corner:
Excavated to 6" and found Osceola County Monument. Excavated to 16" and found tile. Osceola County Monument is positioned in center of tile. Corner is in Fence Row East and West and 3 feet West of Centerline of North and South Road.

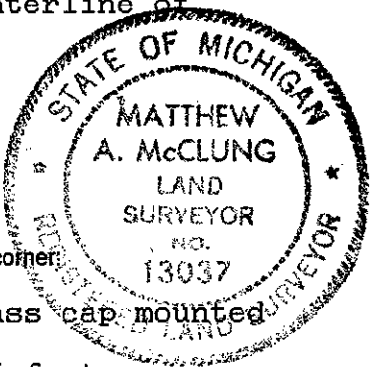

C. Description of monument for corner and accessories established to perpetuate locating the position of the corner:
Corner E-8. Is a Osceola County Monument, which is a 3" brass cap mounted on a 1" pipe 18" in length.
N. Most Point on (48" high X 66" long rock) N79E 41.45 feet.
S. Most Pt on (31" high X 63" long rock) S75E 37.45 feet.
Fence Post East 32.3 feet.
5th Steel Fence Post (N. of Corner) N30E 82.25 feet.

Signed by *Matthew McClung*
Surveyor's Michigan License No. 13037

Date 15 Oct 98

SURVEY &
REMONUMENTATION

NOV 16 1998

SECTION

OSCEOLA COUNTY
REGISTER OF DEEDS

98 OCT 15 PM 4:45

Nancy Crawford

thereby making the corner 4 feet long. Sometimes a solid tile, with a cross in the top was used, and sometimes a 1/2" iron bars were added to the tile. Notes of the work were kept in ledgers, and given to the townships, and 5 of the townships have been entered in the County Surveyors records.