

**SURVEY &
REMONUMENTATION**

NOV 16 1998

SECTION

**LAND CORNER RECORDATION CERTIFICATE
Filing Requirement of Act 74, Mich. P.A. 1970**

For corners in

<u>Osceola</u> (County)	Located In:	Corner Code #
1. Public Land Survey	T <u>20</u> N R <u>7</u> W	<u>E-9</u>
	T <u> </u> R <u> </u>	<u> </u>
	T <u> </u> R <u> </u>	<u> </u>
	T <u> </u> R <u> </u>	<u> </u>
2. Property Controlling in Section	S <u> </u> T <u> </u> R <u> </u>	<u> </u>
	S <u> </u> T <u> </u> R <u> </u>	<u> </u>
3. Miscellaneous Property in Sec.	S <u> </u> T <u> </u> R <u> </u>	<u> </u>
	S <u> </u> T <u> </u> R <u> </u>	<u> </u>

APPROVED LAND CORNER
P.A. 345 OF 1990
Osceola County
Matthew A. McClung
2 July 98
Register of Deeds Stamp & File Number

4. Lot No. _____, Recorded Plat _____
5. Private Claims _____

I, Matthew McClung in a field survey on 6, 23, 1998 do hereby state that under requirements of P.A. 74, Michigan P.A. of 1970, the corner points mentioned in lines 1 and 2 above were in conformance with regulations and rules therefore as required in the current manual of survey instructions of the United States Department of the Interior, Bureau of Land Management or by a decree of a Court of Law and/or that the corner points mentioned in lines 3, 4 and 5 above were in conformance with the rules of the Michigan Board of Land Surveyors or by a Decree of a Court of Law; established, re-established, monumented, recovered, found as expressed below:

NOTE: Not more than 2 corners, all in the same town and range, may be recorded on this certificate.


A	B	C	D	E	F	G	H	I	J	K	L	M
1												
2	6		5		4		3		2		1	
3												
4	7		8		9		10		11		12	
5												
6	18		17		16		15		14		13	
7												
8	19		20		21		22		23		24	
9												
10	30		29		28		27		26		25	
11												
12	31		32		33		34		35		36	
13												

A. Description of original monument and accessories and/or subsequent restoration:
The original corner was set by deputy surveyor Francis Coleman Sept. 27, 1856. Set Post 79.50 from South.
Hemlock 18" N24W 11 lks.
Beech 6" S62E 17 lks
From 1891 to 1904 approximately, Osceola County had a remonumentation program, in which surveyors Temple and Trumbull, did the work. For the most part, a 3" glazed tile filled with cinders from a forge, were placed at each government set corner in the township. There were supposed to be 3 tile per corner, placed atop of each other, (continued on back)

B. Description of corner evidence found and/or method applied in restoring or reestablishing corner:
Found 3/4" Rod in Monument Box. Corner is 3 feet West of centerline of North and South Road and 6 feet North of East and West Road.

C. Description of monument for corner and accessories established to perpetuate locating the position of the corner:
Corner E-9. Is a MSHD stake which is a 3/4" Rod in a Monument Box.

- P. Pole N30E 108.7 feet.
- End. Guard Rail Post N69E 112 feet. O.B.P.
- 20" Maple S15E 111.45 feet O.B.T.
- R/W Marker S20W 68.95 feet O.B.P.

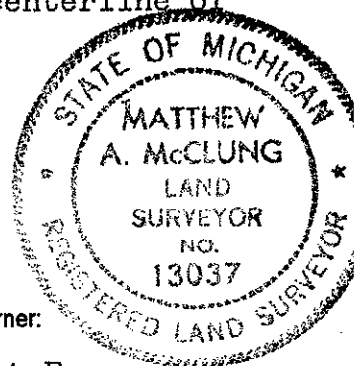

Signed by *Matthew A. McClung*
Surveyor's Michigan License No. 13037

Date 15 Oct 98

SURVEY &
REMONUMENTATION

NOV 16 1998

SECTION

OSCEOLA COUNTY
REGISTER OF DEEDS

98 OCT 15 PM 4:45

Nancy Crawford

thereby making the corner 4 feet long. Sometimes a solid tile, with a cross in the top was used, and sometimes a 1/2" iron bars were added to the tile. Notes of the work were kept in ledgers, and given to the townships, and 5 of the townships have been entered in the County Surveyors records.

Marion Township Book
Pages 28 and 29
Elm SE 100.75'
Elm NE 104.85'

Marion Township Book
Pages 58 and 59
Corner is shafting
Post N48 1/2E 37.4'
Pole S56W 33.6'

and
Tile & Bolt
Telephone pole S39 1/2W 51 lks.
Telephone pole N69 1/2E 81 1/2 lks

Act 132 Liber 302, Page 69
No Witnesses

Act 132 Liber 494 Page 595
No Witnesses

Act 74 Liber 3, Page 93
Fd. 3/4" Rebar in Monument Box
Power Pole N30E 12.65'
End Guard rail post N65E 112.05'
20" Maple S25E 111.10'
R/W Marker S35W 68.8'