

**SURVEY & REMONUMENTATION**

**FEB 12 1998**

**LAND CORNER RECORDATION CERTIFICATE**  
**Filing Requirement of Act 74, Mich. P.A. 1970**

For corners in  
Osceola SECTION  
 (County)

Located In: Corner Code #

- |                                    |       |                            |            |
|------------------------------------|-------|----------------------------|------------|
| 1. Public Land Survey              |       | T <u>20</u> N R <u>7</u> W | <u>F-7</u> |
|                                    |       | T ___ R ___                | _____      |
|                                    |       | T ___ R ___                | _____      |
|                                    |       | T ___ R ___                | _____      |
| 2. Property Controlling in Section | S ___ | T ___ R ___                | _____      |
|                                    | S ___ | T ___ R ___                | _____      |
| 3. Miscellaneous Property in Sec.  | S ___ | T ___ R ___                | _____      |
|                                    | S ___ | T ___ R ___                | _____      |

APPROVED LAND CORNER  
 P.A. 345 OF 1990  
 Osceola County  
*Matthew McClung*  
 24 July 1997  
 Register of Deeds Stamp & File Number

4. Lot No. \_\_\_\_\_, Recorded Plat \_\_\_\_\_  
 5. Private Claims \_\_\_\_\_

I, Matthew McClung, in a field survey on 07-08, 1997 do hereby state that under requirements of P.A. 74, Michigan P.A. of 1970, the corner points mentioned in lines 1 and 2 above were in conformance with regulations and rules therefore as required in the current manual of survey instructions of the United States Department of the Interior, Bureau of Land Management or by a decree of a Court of Law and/or that the corner points mentioned in lines 3, 4 and 5 above were in conformance with the rules of the Michigan Board of Land Surveyors or by a Decree of a Court of Law; established, re-established, monumented, recovered, found as expressed below:

NOTE: Not more than 2 corners, all in the same town and range, may be recorded on this certificate.

1	A	B	C	D	E	F	G	H	I	J	K	L	M
2		6		5		4		3		2		1	
3													
4		7		8		9		10		11		12	
5													
6		18		17		16		15		14		13	
7													
8		19		20		21		22		23		24	
9													
10		30		29		28		27		26		25	
11													
12		31		32		33		34		35		36	
13													

A. Description of original monument and accessories and/or subsequent restoration:

The original corner was set by deputy surveyor Frances Coleman on Nov. 26, 1856. Set wood post 40.00 chains from the West.  
 Beech 8" N61E 40 lks.  
 Beech 8" S27W 23 lks.


From 1891 to 1904 approximately, Osceola County had a remonumentation program, in which surveyors Temple and Trumbull, did the work. For the most part, a 3" glazed tile filled with cinders from a forge, were placed at each government set corner in the township. There were supposed to be 3 tile per corner, placed atop of each other, (continued on back)

B. Description of corner evidence found and/or method applied in restoring or reestablishing corner:

Found Osceola County Monument in centerline of East and West Road 7" below surface. Excavated to 28" and found clay tile. Corner is in fence row North.

C. Description of monument for corner and accessories established to perpetuate locating the position of the corner:

Corner F-7. Osceola County Monument, which is a 3" brass cap mounted on 1" pipe 18" in length.  
 20" Maple NW 23.70 feet.  
 West trunk 10" Double Maple S80E 100.75 feet.  
 7" Elm S42E 38.1 feet.  
 12" Apple S35W 57.6 O.B.T.

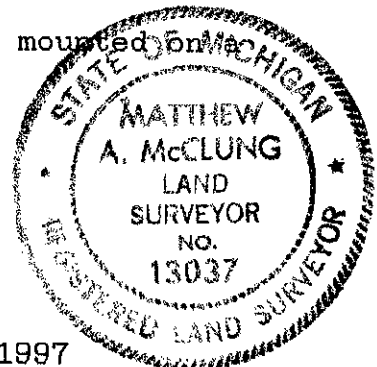

Signed by Matthew McClung  
 Surveyor's Michigan License No. 13037

Date July 8 1997

thereby making the corner 4 feet long. Sometimes a solid tile, with a cross in the top was used, and sometimes a 1/2" iron bars were added to the tile. Notes of the work were kept in ledgers, and given to the townships, and 5 of the townships have been entered in the County Surveyors records.

Marion Township Record Book  
Pages 16-17  
Dated 22 June 1904  
Elm 5" S59W 72lks.

Marion Township Record Book  
Pages 58 & 59  
No Date  
Apple SW 57.4 feet.  
Elm 7" S60W 74. feet.  
Maple 2" S51/2W 29.7 feet.

PA 132  
Liber 299, Page 662  
Sept 1972 by McClung  
No Witnesses

P.A. 132  
Liber 312, Page 667 Dated: 28  
Dated 16 Sept 1986 by McClung  
Found Brass Cap  
6" Elm S40E 37.8 feet  
18" Maple North 23.4 feet.

*Gracey Crawford*  
97 AUG - 7 AM 11:53  
OSCEOLA COUNTY  
REGISTER OF DEEDS

**SURVEY &  
REMONUMENTATION**

**FEB 12 1998**

**SECTION**