

SURVEY & REMONUMENTATION

DEC 13 2000

SECTION

LAND CORNER RECORDATION CERTIFICATE

FILING REQUIREMENT OF ACT 74, Mich. P.A. 1970

For corners in <u>Osceola</u>	Located in:	Corner Code#
1. Public Land Survey	T 20 N R 7 W	F-13
	T R	
	T R	
	T R	
2. Property Controlling in Section	S T R	
	S T R	
3. Miscellaneous Property in Sec.	S T R	
	S T R	
4. Lot No. <u> </u> Recorded Plat <u> </u>		
5. Private Claims <u> </u>		

OSCEOLA COUNTY
 REGISTER OF DEEDS
 00 MAY -5 PM 2:52
James Davidson

Register of Deeds Stamp & File Number

	A	B	C	D	E	F	G	H	I	J	K	L	M
1													
2	6	5	4	3	2	1							
3													
4	7	8	9	10	11	12							
5													
6	18	17	16	15	14	13							
7													
8	19	20	21	22	23	24							
9													
10	30	29	28	27	26	25							
11													
12	31	32	33	34	35	36							
13													

I, Robert L. Wetherell, in a field survey on April 4, 2000, do hereby certify that under requirements of P.A. 74, Michigan P.A. of 1970, the corner points mentioned in lines 1 and 2 above were in conformance with regulations and rules therefore as required in the current manual of survey instructions of the United States Department of the Interior, Bureau of Land Management or by decree of a Court of Law and/or that the corner points mentioned in lines 3, 4, and 5 above were in conformance with the rules of the Michigan Board of Land Surveyors or by a Decree Of a Court of Law; established, re-established, monumented, re-monumented, recovered, found as expressed below:

F-13 - S. 1/4 Cor. Sec. 33, T20N, R7W - Common to N. 1/4 Corner Sec. 4, T19N, R7W

A. Description of original monument and accessories and/or subsequent restoration:

1837 - J. Hodgson, G.L.O.

#1 - 7" Sugar N22°E 46 Links
 #2 - 8" Ironwood N65°W 35 Links

1891-1904 - F. Trumbull, Co. Sur.

Remonumentation of Twp. T20N, R7W
 Set 3" Clay Tile.
 #3 - 6" Birch S25°E 9 3/4 Links
 #4 - 4" Balsam N22 1/2°E 39 1/3 Links

1917 - Co. Sur. Twp. Notes

"Tile".
 #5 - 6" Pine N19 1/2°W 85'
 #6 - 6" Pine S64°W 88'

B. Description of corner evidence found and/or method applied in restoring or reestablishing corner:

I found a 1/2" rod in center of clay tile with cinders. Corner is in the centerline of East and West road and in line with fence to the South.


Condition of the accessories are as follows: #1 Gone, #2 Gone, #3 Gone, #4 Gone, #5 Found in good condition, #6 Found 26" stump.

C. Description of monument for corner and accessories established to perpetuate locating the position of the corner:

I placed a 1" x 18" pipe with Osceola County Remon Cap over top of the 1/2" rod in center of tile, and is accepted as a careful and faithful reestablishment of the position of the original corner.

42" W. Pine N18°W 85.67' (60d spike E. side) #5
 7" W. Pine N67°E 67.20' (60d spike S.E. side)
 T. Pole S03°E 51.78' (P.K. in W. side)
 10"W. Pine S57°W 191.02' (60d spike S.E. side)

APPROVED LAND CORNER
 P.A. 345 OF 1990
 Osceola County
R. L. W.
4-20-2000

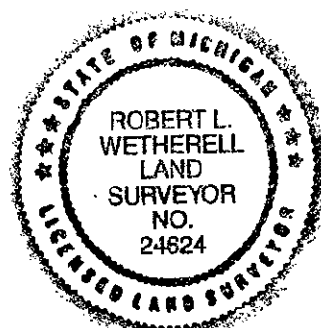

Signed by Robert L. Wetherell
 Surveyor's Michigan License No. 24624

Date April 25, 2000