

DEC 06 1993

COMMISSION

LAND CORNER RECORDATION CERTIFICATE
Filing Requirement of Act 74, Mich. P.A. 1970

For corners in

Osceola (County) Located in: Corner Code # L-13

1. Public Land Survey T 20N R 7W

2. Property Controlling in Section S ___ T ___ R ___

3. Miscellaneous Property in Sec. S ___ T ___ R ___

4. Lot No. _____, Recorded Plat _____

5. Private Claims _____

APPROVED LAND CORNER
P.A. 345 OF 1990
Osceola County

Matthew M. McClung County Reg
12 Nov. 93

Register of Deeds Stamp & File Number

	A	B	C	D	E	F	G	H	I	J	K	L	M
2	6	5	4	3	2	1							
3													
4	7	8	9	10	11	12							
5													
6	18	17	16	15	14	13							
7													
8	19	20	21	22	23	24							
9													
10	30	29	28	27	26	25							
11													
12	31	32	33	34	35	36							
13													


I, Matthew McClung, in a field survey on November 9, 1993, do hereby certify that under requirements of P.A. 74, Michigan P.A. of 1970, the corner points mentioned in lines 1 and 2 above were in conformance with regulations and rules therefore as required in the current manual of survey instructions of the United States Department of the Interior, Bureau of Land Management or by a decree of a Court of Law and/or that the corner points mentioned in lines 3, 4 and 5 above were in conformance with the rules of the Michigan Board of Land Surveyors or by a Decree of a Court of Law; established, re-established, monumented, re-monumented, recovered, found as expressed below:

NOTE: Not more than 4 corners, all in the same town and range, may be recorded on this certificate.

A. Description of original monument and accessories and/or subsequent restoration:
The survey corner was set by deputy surveyor John Hodgson 4th quarter 1837. Set wood post 40 chains from East.
Beech 7" N48E 22 lks.
Lynn 7" N45W 19 lks.
From 1891 to 1904 approximately, Osceola County had a remonumentation program, in which surveyors Temple and Trumbull, did the work. For the most part, a 3" glazed tile filled with cinders from a forge, were placed at each government set corner in the township. There were supposed to be 3 tile per corner, placed atop of each other, (continued on back)

B. Description of corner evidence found and/or method applied in restoring or reestablishing corner:
Found 1/2" bar with sharpened point and cap. (cannot read No.) Found another 1/2" bar 25" below road surface in sand road fill. Found old road surface, and excavated to 33" below road surface, finding 2" to 3" stones around rod. Removed 5 stones, excavated to 37" and found tile. Set Osceola County Monument 7" below road surface, in location of lower bar, and reset bar and cap, stones, and tile chips by monument.

C. Description of monument for corner and accessories established to perpetuate locating the position of the corner:
Corner L-13. Osceola County Monument, which is a 3" brass cap mounted on a 1" pipe 18" in length.
Post by telephone Pedestal N52E 63.28 feet.
Telephone pedestal S20E 81.40 feet.
Post by telephone pedestal S20W 84.17 feet.
Power Pole S68W 75.97 feet.

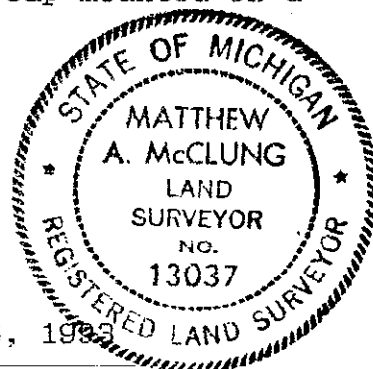

Signed by Matthew M. McClung Date November 6, 1993
Surveyor's Michigan License No. 13037

OSCEOLA COUNTY
REGISTER OF DEEDS

93 NOV 16 PM 2:35

Nancy Crawford

thereby making the corner 4 feet long. Sometimes a solid tile, with a cross in the top was used, and sometimes a 1/2" iron bars were added to the tile. Notes of the work were kept in ledgers, and given to the townships, and 5 of the townships have been recorded in the County records.

This corner is recorded in miscellaneous pages, Marion Twp. Book as: 1/4 1 & 36, Elm 20" SW 63.4 ft. & Elm SE 59.4 ft.

There is a PA. 74 form recorded by Wilcox.