

SURVEY &
REMONUMENTATION

NOV 16 1998

SECTION

LAND CORNER RECORDATION CERTIFICATE
Filing Requirement of Act 74, Mich. P.A. 1970

For corners in

Osceola

(County)

Located In:

Corner Code #

1. Public Land Survey	T <u>20</u> NR <u>8</u> W	<u>G-5</u>
	T ___ R ___	_____
	T ___ R ___	_____
	T ___ R ___	_____
2. Property Controlling in Section	S ___ T ___ R ___	_____
	S ___ T ___ R ___	_____
3. Miscellaneous Property in Sec.	S ___ T ___ R ___	_____
	S ___ T ___ R ___	_____

APPROVED LAND CORNER
P.A. 345 OF 1990
Osceola County

Matthew McClung
2 July 98

Register of Deeds Stamp & File Number

4. Lot No. _____, Recorded Plat _____
5. Private Claims _____

I, Matthew McClung in a field survey on 6, 22, 1998 do hereby state that under requirements of P.A. 74, Michigan P.A. of 1970, the corner points mentioned in lines 1 and 2 above were in conformance with regulations and rules therefore as required in the current manual of survey instructions of the United States Department of the Interior, Bureau of Land Management or by a decree of a Court of Law and /or that the corner points mentioned in lines 3, 4 and 5 above were in conformance with the rules of the Michigan Board of Land Surveyors or by a Decree of a Court of Law; established, re-established, monumented, recovered, found as expressed below:

NOTE: Not more than 2 corners, all in the same town and range, may be recorded on this certificate.

	A	B	C	D	E	F	G	H	I	J	K	L	M
1													
2	6		5		4		3		2		1		
3													
4	7		8		9		10		11		12		
5													
6	18		17		16		15		14		13		
7													
8	19		20		21		22		23		24		
9													
10	30		29		28		27		26		25		
11													
12	31		32		33		34		35		36		
13													

A. Description of original monument and accessories and/or subsequent restoration:

The original corner was set by deputy surveyor Sylvester Sibley July 7, 1938. Set Post 80.00 chs. from South.

Sugar 5" N61 1/2W 26 lks.

Sugar 4" S46 1/2E 13 lks

From 1891 to 1904 approximately, Osceola County had a remonumentation program, in which surveyors Temple and Trumbull, did the work. For the most part, a 3" glazed tile filled with cinders from a forge, were placed at each government set corner in the township. There were supposed to be 3 tile per corner, placed atop of each other, (continued on back)

B. Description of corner evidence found and/or method applied in restoring or reestablishing corner:

Hired Backhoe Excavated to 9 feet found Osceola County Monument at 5 feet and Rifle Barrel at 6.5 feet. Placed Osceola County Monument over rifle Barrel at 6' below road surface. Corner is 4 feet North of centerline of East & West Road and in the center line of North and South Road. I measured distances from G-4 to G-5 = 2608.43' and G-5 to F-5 = 2616.41'

C. Description of monument for corner and accessories established to perpetuate locating the position of the corner:


Corner G-5. Osceola County Monument, which is a 3" brass cap mounted on a 1" pipe 18" in length.

P.P. N74E 282.63 feet

P.P. N71W 52.60 feet.

P.P. N84W 348.345 feet.

P.P. N20w 348.005 feet.

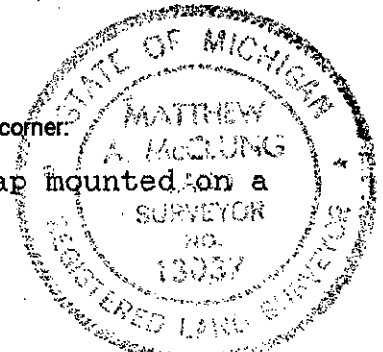

Signed by *Matthew McClung*
Surveyor's Michigan License No. 13037

Date 15 Oct 98

SURVEY &
REMONUMENTATION

OSCEOLA COUNTY
REGISTER OF DEEDS

NOV 16 1998

98 OCT 15 PM 4:46

SECTION

Nancy Crawford

thereby making the corner 4 feet long. Sometimes a solid tile, with a cross in the top was used, and sometimes a 1/2" iron bars were added to the tile. Notes of the work were kept in ledgers, and given to the townships, and 5 of the townships have been entered in the County Surveyors records.

Highland Twp. Book, pages 72 & 73
Dated 1919
Gun barrel
NE Cor Bridge N69W 29.3'
SE Cor Bridge S72W 29.9'

County Survey record setting tile
Hemlock 10" N15W 22
Sugar 2" N65E 65
Beech down

Highland Twp. Book, pages 20 & 21.
Shows distance from G-4 to G-5 =2607.77'.

Act. 132, Liber 521, page 562
Set 5/8" rod/cap
by recorded distances
No Witnesses

Act 74, Liber 2, pages 368
Buried deep by Co. road reset by
recorded distances in county records.