

**SURVEY & REMONUMENTATION**

NOV 01 1999

**LAND CORNER RECORDATION CERTIFICATE**  
Filing Requirement of Act 74, Mich. P.A. 1970

**SECTION**

For corners in

Osceola

(County)

Located In:

Corner Code #

1. Public Land Survey

T 20N R 8W      G-6

T    R                      \_\_\_\_\_

T    R                      \_\_\_\_\_

T    R                      \_\_\_\_\_

2. Property Controlling in Section

S    T    R                      \_\_\_\_\_

S    T    R                      \_\_\_\_\_

3. Miscellaneous Property in Sec.

S    T    R                      \_\_\_\_\_

S    T    R                      \_\_\_\_\_

4. Lot No. \_\_\_\_\_, Recorded Plat \_\_\_\_\_

5. Private Claims \_\_\_\_\_

APPROVED LAND CORNER  
P.A. 345 OF 1990  
Osceola County

*Matthew McClung*  
20 May 1999

Register of Deeds Stamp & File Number

I, Matthew McClung in a field survey on 5 6, 1999 do hereby state that under requirements of P.A. 74, Michigan P.A. of 1970, the corner points mentioned in lines 1 and 2 above were in conformance with regulations and rules therefore as required in the current manual of survey instructions of the United States Department of the Interior, Bureau of Land Management or by a decree of a Court of Law and/or that the corner points mentioned in lines 3, 4 and 5 above were in conformance with the rules of the Michigan Board of Land Surveyors or by a Decree of a Court of Law, established, re-established, monumented, recovered, found as expressed below:

NOTE: Not more than 2 corners, all in the same town and range, may be recorded on this certificate.

	A	B	C	D	E	F	G	H	I	J	K	L	M
1													
2	6		5		4		3		2		1		
3													
4	7		8		9		10		11		12		
5													
6	18		17		16		15		14		13		
7													
8	19		20		21		22		23		24		
9													
10	30		29		28		27		26		25		
11													
12	31		32		33		34		35		36		
13													

A. Description of original monument and accessories and/or subsequent restoration:  
The original corner was set by deputy surveyor Sylvester Sibley July 7, 1938. Corner is 8" Beech set 40 chains from the South.


From 1891 to 1904 approximately, Osceola County had a remonumentation program, in which surveyors Temple and Trumbull, did the work. For the most part, a 3" glazed tile filled with cinders from a forge, were placed at each government set corner in the township. There were supposed to be 3 tile per corner, placed atop of each other, (continued on back)

B. Description of corner evidence found and/or method applied in restoring or reestablishing corner:

Excavated 6" below surface and found top of 1" iron rod. Excavated 14" below road surface and found top of 2" rod. Excavated 16" below surface and found solid tile. Tile center is .15' south of center of 1" iron rod. Placed Osceola County Monument in original position over center of tile. Placed 1" iron rod next to County Monument.

C. Description of monument for corner and accessories established to perpetuate locating the position of the corner:

Corner G-6. Osceola County Monument, which is a 3" brass cap mounted on a 1" pipe 18" in length.  
Power Pole w/spike Due West 29.4 feet. O.B.P.  
24" W. Pine w/spike S62E 34.5 feet. O.B.P.  
20" Red Pine S18E 135.6 feet.  
15" Red Pine S12E 99.45 feet.

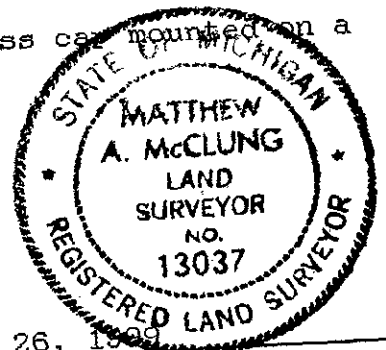


Signed by *Matthew McClung*  
Surveyor's Michigan License No. 13037

Date May 26, 1999

OSCEOLA COUNTY  
REGISTER OF DEEDS

99 JUN -4 PM 5: 03

*Nancy Crawford*

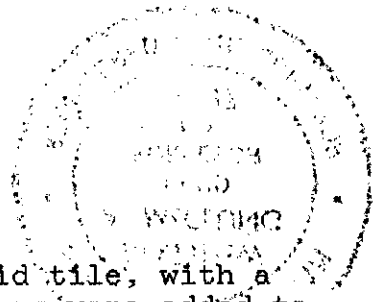

thereby making the corner 4 feet long. Sometimes a solid tile, with a cross in the top was used, and sometimes a 1/2" iron bars were added to the tile. Notes of the work were kept in ledgers, and given to the townships, and 5 of the townships have been entered in the County Surveyors records.

Highland Twp. Book, pages 72 & 73  
6= Tile Dated 1919.  
Shaft Post N87W 15.6 ft.  
Post S88E 23. ft.  
REA 48SW 29 ft.  
Stone S27E 38.2 ft.  
Hem 30" N71W 16.8 ft.

Act 132, Liber 636, Page 677  
Dated: 31 Mar 1998 by Wade-Trim  
Fd. 3/4" Iron  
N85W P. Pole 29.52' FD.  
S55E 20" W. Pine 34.60 FD.  
East 16" Cherry 64.18' FD.  
N75E 8" Cherry 28.65' Fd. (dying)

Act 132, Liber 645 Page 113  
Dated 12, Aug 1998 by McClung  
Fd. Tile  
Set. Osceola County Monuemnt.  
P. Pole West 29.4 ft.  
24" W. Pine S62E 343.5 ft.  
20" R. Pine S18E 135.6 ft.  
15" R. Pine S12E 99.45 ft.

**SURVEY &  
REMONUMENTATION**

NOV 01 1999

SECTION