

**SURVEY &  
REMONUMENTATION**

**LAND CORNER RECORDATION CERTIFICATE  
Filing Requirement of Act 74, Mich. P.A. 1970**

DEC 16 1996

For corners in  
Osceola  
(County)

Located In: Corner Code #

- |                                    |   |            |           |            |
|------------------------------------|---|------------|-----------|------------|
| 1. Public Land Survey              | T | <u>20N</u> | <u>8W</u> | <u>H-7</u> |
|                                    | T | R          |           |            |
|                                    | T | R          |           |            |
|                                    | T | R          |           |            |
| 2. Property Controlling in Section | S | T          | R         |            |
|                                    | S | T          | R         |            |
| 3. Miscellaneous Property in Sec.  | S | T          | R         |            |
|                                    | S | T          | R         |            |

COMMISSION

APPROVED LAND CORNER  
P.A. 345 OF 1990  
Osceola County

*Matthew McClung*  
7 Nov. 1996

Register of Deeds Stamp & File Number

4. Lot No. \_\_\_\_\_, Recorded Plat \_\_\_\_\_  
5. Private Claims \_\_\_\_\_

Matthew McClung 10-2 96

I, \_\_\_\_\_, in a field survey on \_\_\_\_\_, 19\_\_\_\_ do hereby state that under requirements of P.A. 74, Michigan P.A. of 1970, the corner points mentioned in lines 1 and 2 above were in conformance with regulations and rules therefore as required in the current manual of survey instructions of the United States Department of the Interior, Bureau of Land Management or by a decree of a Court of Law and/or that the corner points mentioned in lines 3, 4 and 5 above were in conformance with the rules of the Michigan Board of Land Surveyors or by a Decree of a Court of Law; established, re-established, monumented, recovered, found as expressed below:

NOTE: Not more than 2 corners, all in the same town and range, may be recorded on this certificate.

A	B	C	D	E	F	G	H	I	J	K	L	M
1												
2	6	5	4	3	2	1						
3												
4	7	8	9	10	11	12						
5												
6	18	17	16	15	14	13						
7												
8	19	20	21	22	23	24						
9												
10	30	29	28	27	26	25						
11												
12	31	32	33	34	35	36						
13												

**A. Description of original monument and accessories and/or subsequent restoration:**

The original corner was set by deputy surveyor Silvester Sibley May 13, 1938. Set wood post 80.00 chains from the South.  
Sugar 10" N03E 21 lks.  
Sugar 6" N27E 7 lks.


From 1891 to 1904 approximately, Osceola County had a remonumentation program, in which surveyors Temple and Trumbull, did the work. For the most part, a 3" glazed tile filled with cinders from a forge, were placed at each government set corner in the township. There were supposed to be 3 tile per corner, placed atop of each other, (continued on back)

**B. Description of corner evidence found and/or method applied in restoring or reestablishing corner:**

Found 1/2" rod and cap at surface. Excavated to 18", removed rod and found 1" pipe with union on top. Excavated to 31" and found telephone line and dug no deeper. Pulled 1" pipe which is 3' long and got strong reading with magnetic locator. Placed Osceola County Monument over 1" pipe. Road fill is probably 6 feet at this point. This corner 5' South of Road Center Line and is in a fence row to South.

**C. Description of monument for corner and accessories established to perpetuate locating the position of the corner:**

- Corner H-7. Osceola County Monument, which is a 3" brass cap mounted on 1" pipe 18" in length.  
Power Pole North 128.77 feet.  
24" Sugar Maple S25W 22.28 feet. O.B.T.  
24" Sugar Maple S50E 28.95 feet.  
24" Sugar Maple N70W 113.00 feet.

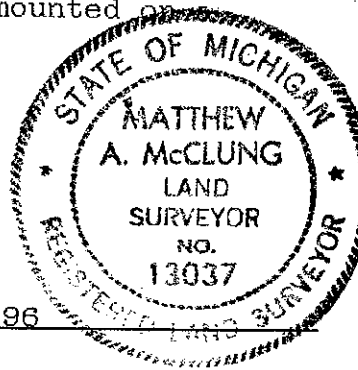

Signed by *Matthew McClung*  
Surveyor's Michigan License No. 13037

Date Oct. 2 1996

OSCEOLA COUNTY  
REGISTER OF DEEDS

96 NOV 26 PM 2:15

*Spencer Crawford*

thereby making the corner 4 feet long. Sometimes a solid tile, with a cross in the top was used, and sometimes a 1/2" iron bars were added to the tile. Notes of the work were kept in ledgers, and given to the townships, and 5 of the townships have been entered in the County Surveyors records.

Highland Township Records Book: Pages 72 and 73. 1/2 Mile to West is 2649.7 feet and to the East it is 2606.0 feet.

There is 1 P.A. 132 recorded: Liber 326, Page 177.

SURVEY &  
REMONUMENTATION

DEC 1 6 1996

COMMISSION