

FEB 24 2000

LAND CORNER RECORDATION CERTIFICATE

FILING REQUIREMENT OF ACT 74, Mich. P.A. 1970

SECTION

For corners in <u>Osceola</u>	Located in:	Corner Code#
1. Public Land Survey	T 20 N R 8 W	I-1
	T R	
	T R	
	T R	
2. Property Controlling s in Section	T R	
	S T R	
3. Miscellaneous Property in Sec.	S T R	
	S T R	
4. Lot No. _____ Recorded Plat		
5. Private Claims		

OSCEOLA COUNTY
 REGISTER OF DEEDS
 99 NOV 19 PH12:09
Mary Campbell

Register of Deeds Stamp & File Number

	A	B	C	D	E	F	G	H	I	J	K	L	M
1													
2	6	5	4	3	2	1							
3													
4	7	8	9	10	11	12							
5													
6	18	17	16	15	14	13							
7													
8	19	20	21	22	23	24							
9													
10	30	29	28	27	26	25							
11													
12	31	32	33	34	35	36							
13													

I, Robert L. Wetherell, in a field survey on September 30 1999, do hereby certify that under requirements of P.A. 74, Michigan P.A. of 1970, the corner points mentioned in lines 1 and 2 above were in conformance with regulations and rules therefore as required in the current manual of survey instructions of the United States Department of the Interior, Bureau of Land Management or by decree of a Court of Law and/or that the corner points mentioned in lines 3, 4, and 5 above were in conformance with the rules of the Michigan Board of Land Surveyors or by a Decree Of a Court of Law; established, re-established, monumented, re-monumented, recovered, found as expressed below:

NOTE: ONLY ONE CORNER MAY BE RECORDED ON THIS CERTIFICATE.

NW Corner of Section 2, T20N,R8W

A. Description of original monument and accessories and/or subsequent restoration:

<u>1838 J. Hodgson</u> Set Post #1-18" Beech N43W 23 LK. #2-12" Beech N49E 43LK	<u>1891- L. June</u> "Two OBT's found" Set 3" Clay tiles	<u>1923-1956 F. McClung</u> Page 84 & 85 Tile and iron #3-Elm NE 59.0' #4 -TP SE 54.7' Dist. South 4411.5' Dist. East 2649.5'	<u>1999 M. McClung LS13037</u> Unrecorded Survey Fd. Solid Tile & 5/8" Iron Rod Set Osceola Co. Monument #5- P. Pole N44W 107.0' #6- Cor. P. Post (Treated) N16E 36.15' #7-6" Ash South 40.40' #8- NE most in clump S12W 40.55' Dist. South 4415.11' Dist East 2648.2'
--	--	---	---

B. Description of corner evidence found and/or method applied in restoring or reestablishing corner:

I found an Osceola County Monument in line with a fence South and in the C/L of an East and West Road.

Condition of the accessories are as follow: #1 Gone, #2 Gone, #3 Gone, #4 Gone, #5 Found in good condition, #6 Found in good condition, #7 Found in good condition and #8 Found in good condition.

C. Description of monument for corner and accessories established to perpetuate locating the position of the corner:


I accept the Osceola County Monument (1 1/2" pipe with an Osceola County Remon Cap) as a substantial marker of the corner and is accepted as a careful and faithful perpetuation of the position of the original corner.

- 8" Basswood NE Most in clump S12W 40.84' (Nail on East Side) - #8
- 6" Ash South 40.60' (Nail on West Side) - #7
- Corner Fence Post N16E 36.15' (Center) - #6
- P. Pole N44W 107.00' (Center) - #5

Signed by Robert L. Wetherell

Date Nov-9, 1999

Surveyor's Michigan License No. 24624

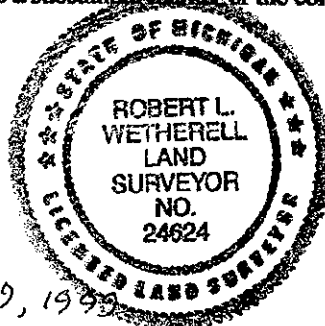

APPROVED LAND CORNER
P.A. 74 OF 1990
Osceola County
10-21-99
R L W

FORM APPROVED BY MICHIGAN STATE BOARD OF LAND SURVEYORS, JAN. 28, 1971
REVISED MAY 14, 1975
REVISED JAN. 1983
ADAPTED FOR WORD PROCESSING JANUARY, 1999