

SURVEY & REMONUMENT

AUG 23 1995

LAND CORNER RECORDATION CERTIFICATE
Filing Requirement of Act 74, Mich. P.A. 1970

For corners in **OSCEOLA**

	Osceola (County)	Located In:	Corner Code #
1. Public Land Survey		20N 8W	I-9
		T ___ R ___	_____
		T ___ R ___	_____
		T ___ R ___	_____
		T ___ R ___	_____
2. Property Controlling in Section	S ___	T ___ R ___	_____
	S ___	T ___ R ___	_____
3. Miscellaneous Property in Sec.	S ___	T ___ R ___	_____
	S ___	T ___ R ___	_____

APPROVED LAND CORNER
P.A. 345 OF 1990
Osceola County

27 June 1995
Matthew M. Clung

Register of Deeds Stamp & File Number

4. Lot No. _____, Recorded Plat _____
 5. Private Claims _____

Matthew McClung, in a field survey on **June 15, 1995**, do hereby certify that under requirements of P.A. 74, Michigan P.A. of 1970, the corner points mentioned in lines 1 and 2 above were in conformance with regulations and rules therefore as required in the current manual of survey instructions of the United States Department of the Interior, Bureau of Land Management or by a decree of a Court of Law and/or that the corner points mentioned in lines 3, 4 and 5 above were in conformance with the rules of the Michigan Board of Land Surveyors or by a Decree of a Court of Law; established, re-established, monumented, re-monumented, recovered, found as expressed below:

	A	B	C	D	E	F	G	H	I	J	K	L	M
2	6	5	4	3	2	1							
3													
4	7	8	9	10	11	12							
5													
6	18	17	16	15	14	13							
7													
8	19	20	21	22	23	24							
9													
10	30	29	28	27	26	25							
11													
12	31	32	33	34	35	36							
13													

NOTE: Not more than 4 corners, all in the same town and range, may be recorded on this certificate.


A. Description of original monument and accessories and/or subsequent restoration:

The original corner was set by deputy surveyor Sylvester Sibley, 30 January, 1838 set wood post 80.00 chains from the South.
 Beech 12" S21E 34 Lks.
 Beech 12" N41W 40 Lks.

From 1891 to 1904 approximately, Osceola County had a remonumentation program, in which surveyors Temple and Trumbull, did the work. For the most part, a 3" glazed tile filled with cinders from a forge, were placed at each government set corner in the township. There were supposed to be 3 tile per corner, placed atop of each other, (continued on back)

B. Description of corner evidence found and/or method applied in restoring or reestablishing corner:

Found 1/2" rod in Monument box. Corner is in a road cut and probably tile has been destroyed. Excavated to 14" and found no other evidence of corner. Placed Osceola County Monument over rod 2" below surface.

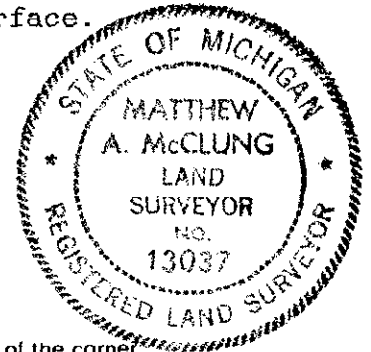

C. Description of monument for corner and accessories established to perpetuate locating the position of the corner:

Corner I-9. Osceola County Monument, which is a 3" brass cap mounted on a 1" pipe 30" in length.
 Telephone pedestal S34E 74.2 feet.
 Southwest corner headwall S54W 21.73 feet.
 14" Maple N46E 108.55 feet.
 Telephone pedestal N20E 84.15 feet.

Signed by *Matthew M. Clung* Date June 15, 1995
 Surveyor's Michigan License No. 13037

FORM APPROVED BY MICHIGAN STATE BOARD OF LAND SURVEYORS, JAN. 28, 1971
 REVISED MAY 14, 1975
 REVISED JAN., 1983

OSCEOLA COUNTY
REGISTER OF DEEDS

95 JUL -6 AM 10:41

Nancy Crawford

thereby making the corner 4 feet long. Sometimes a solid tile, with a cross in the top was used, and sometimes a 1/2" iron bars were added to the tile. Notes of the work were kept in ledgers, and given to the townships, and 5 of the townships have been recorded in the County records.

I have shown 2 LCRC of Act 74 certificates.

I have shown 3 PA 132 survey certificates.

Osceola County Records, Highland Township book, pages 12 and 13 and pages 82 and 83.