

**SURVEY & REMONUMENTATION**

APR 25 1995

**LAND CORNER RECORDATION CERTIFICATE**  
**Filing Requirement of Act 74, Mich. P.A. 1970**

**COMMISSION**

For corners in

Osceola  
 (County)

Located In:

Corner Code #

- |                                    |                          |             |
|------------------------------------|--------------------------|-------------|
| 1. Public Land Survey              | T <u>20N</u> R <u>8W</u> | <u>K-10</u> |
|                                    | T _____ R _____          | _____       |
|                                    | T _____ R _____          | _____       |
|                                    | T _____ R _____          | _____       |
| 2. Property Controlling in Section | S _____ T _____ R _____  | _____       |
|                                    | S _____ T _____ R _____  | _____       |
| 3. Miscellaneous Property in Sec.  | S _____ T _____ R _____  | _____       |
|                                    | S _____ T _____ R _____  | _____       |

4. Lot No. \_\_\_\_\_, Recorded Plat \_\_\_\_\_  
 5. Private Claims \_\_\_\_\_

APPROVED LAND CORNER  
 P.A. 345 OF 1990  
 Osceola County

*29 Nov. 1994*  
*Matthew McClung*

Register of Deeds Stamp & File Number

Matthew McClung, in a field survey on November 28, 19 1994, do hereby certify that under requirements of P.A. 74, Michigan P.A. of 1970, the corner points mentioned in lines 1 and 2 above were in conformance with regulations and rules therefore as required in the current manual of survey instructions of the United States Department of the Interior, Bureau of Land Management or by a decree of a Court of Law and/or that the corner points mentioned in lines 3, 4 and 5 above were in conformance with the rules of the Michigan Board of Land Surveyors or by a Decree of a Court of Law; established, re-established, monumented, re-monumented, recovered, found as expressed below:

**NOTE: Not more than 4 corners, all in the same town and range, may be recorded on this certificate.**

	A	B	C	D	E	F	G	H	I	J	K	L	M
2	6	5	4	3	2	1							
3													
4	7	8	9	10	11	12							
5													
6	18	17	16	15	14	13							
7													
8	19	20	21	22	23	24							
9													
10	30	29	28	27	26	25							
11													
12	31	32	33	34	35	36							
13													

**A. Description of original monument and accessories and/or subsequent restoration:**

The original corner was set by deputy surveyor Sylvester Sibley, 7 July 1838. Set wood post 40.00 chains from the South.

Sugar 12" S89W 10 Lks.

Pine 10" S65E 25 lks.

From 1891 to 1904 approximately, Osceola County had a remonumentation program, in which surveyors Temple and Trumbull, did the work. For the most part, a 3" glazed tile filled with cinders from a forge, were placed at each government set corner in the township. There were supposed to be 3 tile per corner, placed atop of each other, (continued on back)

**B. Description of corner evidence found and/or method applied in restoring or reestablishing corner:**

Found Osceola County Monument 1" below asphalt road surface. Corner is in cut 7 feet deep, so there is no chance of finding original or tile corner. I think this monument is the second County Monument placed for this corner. The P.A. 74 form, Lib. 3, page 41, recorded by Erickson, is in error. It fits the corner evidence found for the Section corner south of this corner. Found Northwest corner of abandon school to fit 1905 record.

**C. Description of monument for corner and accessories established to perpetuate locating the position of the corner:**


Corner K-10. Osceola County Monument, which is a 3" brass cap mounted on 1" pipe 18" in length.

SW Corner of Church S80E 93.11 feet.

30" Maple S70E 83.27 feet.

NW Corner of Brick planter for church sign S65E 81.16 feet.

NW corner of abandon school S45E 91.95 feet. O.B.P.

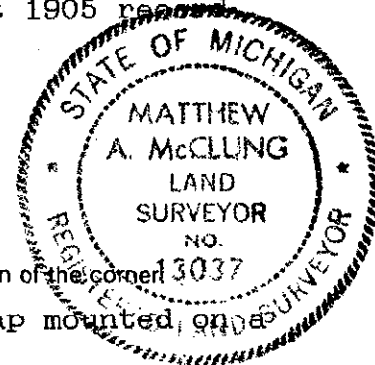

Signed by Matthew McClung  
 Surveyor's Michigan License No. 13037

NOV 6 1993  
 Date November 6, 1993  
 OSCEOLA COUNTY

FORM APPROVED BY MICHIGAN STATE BOARD OF LAND SURVEYORS, JAN. 26, 1971  
 REVISED MAY 14, 1975  
 REVISED JAN., 1983

OSCEOLA COUNTY  
REGISTER OF DEEDS

94 DEC -7 PM 2:51

*Nancy Crawford*

thereby making the corner 4 feet long. Sometimes a solid tile, with a cross in the top was used, and sometimes a 1/2" iron bars were added to the tile. Notes of the work were kept in ledgers, and given to the townships, and 5 of the townships have been recorded in the County records.

This corner has a PA 74 form recorded, Liber 3, Page 41.

There are 3 P.A. 132 forms pertaining to this corner.

The corner is recorded on page 34 the Township Book.

RECORDED  
INDEXED  
DEC 7 1994  
OSCEOLA COUNTY REGISTER OF DEEDS