

**SURVEY &
REMONUMENTATION**

APR 25 1995

**LAND CORNER RECORDATION CERTIFICATE
Filing Requirement of Act 74, Mich. P.A. 1970**

COMMISSION

For corners in
Osceola

	(County)	Located In:	Corner Code #
		20N 8W	L-11
1. Public Land Survey		T ___ R ___	_____
		T ___ R ___	_____
		T ___ R ___	_____
		T ___ R ___	_____
2. Property Controlling in Section	S ___ T ___	R ___	_____
	S ___ T ___	R ___	_____
3. Miscellaneous Property in Sec.	S ___ T ___	R ___	_____
	S ___ T ___	R ___	_____
4. Lot No. _____, Recorded Plat _____			
5. Private Claims _____			

**APPROVED LAND CORNER
P.A. 345 OF 1990
Osceola County**

Matthew A. McClung
29 Nov 1994

Register of Deeds Stamp & File Number

Matthew McClung November 28, 1994
do hereby certify that under requirements of P.A. 74, Michigan P.A. of 1970, the corner points mentioned in lines 1 and 2 above were in conformance with regulations and rules therefore as required in the current manual of survey instructions of the United States Department of the Interior, Bureau of Land Management or by a decree of a Court of Law and/or that the corner points mentioned in lines 3, 4 and 5 above were in conformance with the rules of the Michigan Board of Land Surveyors or by a Decree of a Court of Law, established, re-established, monumented, re-monumented, recovered, found as expressed below:

NOTE: Not more than 4 corners, all in the same town and range, may be recorded on this certificate.

	A	B	C	D	E	F	G	H	I	J	K	L	M
2	6	5	4	3	2	1							
3													
4	7	8	9	10	11	12							
5													
6	18	17	16	15	14	13							
7													
8	19	20	21	22	23	24							
9													
10	30	29	28	27	26	25							
11													
12	31	32	33	34	35	36							
13													


A. Description of original monument and accessories and/or subsequent restoration
The original corner was set by deputy surveyor Sylvester Sibley, 7 July 1838. Set wood post 39.91 chains from the East.
Beech 6" S42W 24 Lks.
Beech 14" N69E 12 lks.
From 1891 to 1904 approximately, Osceola County had a remonumentation program, in which surveyors Temple and Trumbull, did the work. For the most part, a 3" glazed tile filled with cinders from a forge, were placed at each government set corner in the township. There were supposed to be 3 tile per corner, placed atop of each other, (continued on back)

B. Description of corner evidence found and/or method applied in restoring or reestablishing corner
Found Osceola County Monument at road surface. Monument was bent 45 degrees to the East, 6" below the surface. Excavated to 6" and found plow point. Excavated to 8" and found tile. Placed straight Osceola County Monument in center of tile. The corner is in the fence line to the south.

C. Description of monument for corner and accessories established to perpetuate locating the position of the corner:
Corner L-11. Osceola County Monument, which is a 3" brass cap mounted on a 1" pipe 18" in length.
Fence Post South 27.5 feet. O.B.P.
5" R. Pine N45W 47.95 feet.
6" R. Pine N10W 59.70 feet.
6" R. Pine S15E 48.15 feet.

Signed by Matthew McClung 13037
Surveyor's Michigan License No. _____

November 6, 1993
Date: _____
OSCEOLA COUNTY

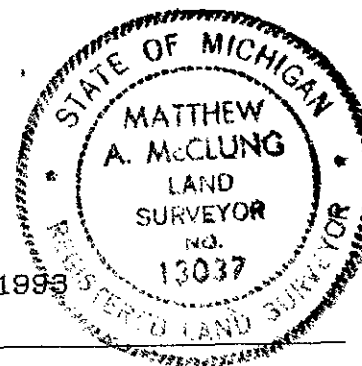


FORM APPROVED BY MICHIGAN STATE BOARD OF LAND SURVEYORS, JAN. 28, 1971
REVISED MAY 14, 1975
REVISED JAN., 1983

OSCEOLA COUNTY
REGISTER OF DEEDS

94 DEC -7 PM 2: 50

Nancy Crawford

 

thereby making the corner 4 feet long. Sometimes a solid tile, with a cross in the top was used, and sometimes a 1/2" iron bars were added to the tile. Notes of the work were kept in ledgers, and given to the townships, and 5 of the townships have been recorded in the County records.

This corner has a PA 74 form recorded, Liber 1, Page 165.

There are 4 P.A. 132 forms pertaining to this corner.

The corner is recorded in the front pages the Township Book.

1894
1895
