

**SURVEY &
REMONUMENTATION**

NOV 16 1998

SECTION

**LAND CORNER RECORDATION CERTIFICATE
Filing Requirement of Act 74, Mich. P.A. 1970**

For corners in

Osceola
(County)

Located In:

Corner Code #

- | | | |
|------------------------------------|---------------------------|--------------|
| 1. Public Land Survey | T <u>20</u> NR <u>8</u> W | <u>M-9</u> ✓ |
| | T _____ R _____ | |
| | T <u>20</u> NR <u>7</u> W | <u>A-9</u> |
| | T _____ R _____ | |
| 2. Property Controlling in Section | S _____ T _____ | |
| | S _____ T _____ | |
| 3. Miscellaneous Property in Sec. | S _____ T _____ | |
| | S _____ T _____ | |

APPROVED LAND CORNER
P.A. 345 OF 1990
Osceola County
Matthew McClung
2 July 98
Register of Deeds Stamp & File Number

4. Lot No. _____, Recorded Plat _____
5. Private Claims _____


I, Matthew McClung in a field survey on 6, 23, 1998 do hereby state that under requirements of P.A. 74, Michigan P.A. of 1970, the corner points mentioned in lines 1 and 2 above were in conformance with regulations and rules therefore as required in the current manual of survey instructions of the United States Department of the Interior, Bureau of Land Management or by a decree of a Court of Law and /or that the corner points mentioned in lines 3, 4 and 5 above were in conformance with the rules of the Michigan Board of Land Surveyors or by a Decree of a Court of Law, established, re-established, monumented, recovered, found as expressed below:

NOTE: Not more than 2 corners, all in the same town and range, may be recorded on this certificate.

	A	B	C	D	E	F	G	H	I	J	K	L	M
1													
2	6		5		4		3		2		1		
3													
4	7		8		9		10		11		12		
5													
6	18		17		16		15		14		13		
7													
8	19		20		21		22		23		24		
9													
10	30		29		28		27		26		25		
11													
12	31		32		33		34		35		36		
13													

A. Description of original monument and accessories and/or subsequent restoration:
The original corner was set by deputy surveyor John Hodgson Dec. 23, 1938.
Set Post 80.00 chains. from South.
Sugar 8 S33W 44 lks.
Beech 12" N42E 35 lks
From 1891 to 1904 approximately, Osceola County had a remonumentation program, in which surveyors Temple and Trumbull, did the work. For the most part, a 3" glazed tile filled with cinders from a forge, were placed at each government set corner in the township. There were supposed to be 3 tile per corner, placed atop of each other, (continued on back)

B. Description of corner evidence found and/or method applied in restoring or reestablishing corner:
Found Osceola County Monument in Monument Box. Corner is in centerline of Road North and 2 feet South of centerline of East and West Road. Found Old Bearing Tree, as called in Marion Twp. Book.

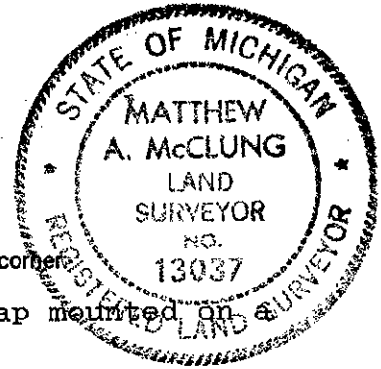

C. Description of monument for corner and accessories established to perpetuate locating the position of the corner:
Corner M-9. Osceola County Monument, which is a 3" brass cap mounted on a 1" pipe 18" in length.
Telephone Ped. S13E 52.60 feet.
Telephone Ped. N30E 71.65 feet.
36" Maple N35E 80.75 feet O.B.T.
14" Apple S60W 67.35 feet.

Signed by Matthew McClung
Surveyor's Michigan License No. 13037

Date 10 Oct 98

SURVEY &
REMONUMENTATION

NOV 16 1998

SECTION

OSCEOLA COUNTY
REGISTER OF DEEDS

98 OCT 15 PM 4:46

Nancy Crawford

thereby making the corner 4 feet long. Sometimes a solid tile, with a cross in the top was used, and sometimes a 1/2" iron bars were added to the tile. Notes of the work were kept in ledgers, and given to the townships, and 5 of the townships have been entered in the County Surveyors records.

Highland Township Book

Pages 56 and 57

Found Tile Dated 1916

Tel pole N31 1/2E 43.4'

Pole S1 1/2E 18.8'

Marion Township Book, Dated 1926

Pages 68 and 69 Tile & Iron

24" Maple N37E 79.6'

12" Apple S31W 80.31'

12" Apple S45W 54.9"

Osceola County Records

For setting tiles Highland Twp.

B.Ts Stumps and old stake

Act 132 Liber 289 Pages 230

No Witnesses

Act 74 Liber 1, page 13

6" piece of pipe

Brass Cap Attached to 18" pipe

30" Maple N37E 79.6'

R/W marker N30E 72.0'

C/1 E. end of culvert

S10E 24.5'

Act 74 Liber 1 Page 15

Same as Liber 1, Page 13

Act 74 Liber 1, Page 154

Fd Tile & Iron

24" Maple N37E 79.6'

R/W Marker N30E 72.0'