

LAND CORNER RECORDATION CERTIFICATE

FILING REQUIREMENT OF ACT 74, MICH. P.A.1970

FOR CORNERS OF --:	LOCATED IN --:	CORNER CODE NUMBER
1. PUBLIC LAND SURVEY	T N. S., R. E. W.	3, W.C. N02°23'56"W - 17.79 FROM 3;
2. PROPERTY CONTROLLING IN SECTION 4	26 N. R. 1 E.	5; 3, W.C. N89°06'10"E 45.22' FROM 3
3. MISCELLANEOUS PROPERTY IN SECTION	N. S., R. E. W.	
4. LOT NO., RECORDED PLAT		
5. PRIVATE CLAIMS		

REGISTER OF DEEDS STAMP AND FILING NUMBER

I, **KENNETH J. OSTLING**, do hereby certify that under requirements of P.A. 74, Michigan P.A. of 1970, the corner points mentioned in lines 1 and 2 above were, in a field survey on **JANUARY 6**, 1984, established, re-established, monumented, re-monumented, recovered or restored as expressed below and in conformance with regulations and rules therefore as required in the current manual of survey instructions of the United States Department of the Interior, Bureau of Land Management or by a decree of a court of law. Furthermore, that the corner points mentioned in lines 3, 4 and 5 above were, in a field survey on _____, 19____, found, recovered, restored, established or re-established as expressed below and in conformance with the rules of the Michigan State Board of Registration for Land Surveyors or, by a Decree of a Court of law:

C. CONTINUED:

XX

3, W.C. N02°23'56"W 17.79 FROM 3
 SET 5/8" ROD W/RLS CAP
 30" CEDAR STP N14°W 22.9'
 7" B. ASH N40°E 6.9'

SET 4" SQ. CEDAR POST W/LOC TAG
 BY CORNER

B. Description of corner evidence found and/or method applied in restoring or re-establishing corner:


- 5 - SET BY STANDARD SURVEY PROCEDURE FOR THE SUBDIVISION OF SECTIONS.
- 3, W.C. N89°06'10"E 45.22' FROM 3 - SET BY STANDARD SURVEY PROCEDURE. 1/8 CORNER FALLS IN RIVER.
- 3, W.C. N02°23'56"W 17.79' FROM 3 - SET BY STANDARD SURVEY PROCEDURE. 1/8 CORNER FALLS IN RIVER.

C. Description of monument for corner and accessories established to perpetuate locating the position of the corner:

- | | |
|---|---|
| <p style="text-align: center;"><u>5</u></p> <p>SET 5/8" ROD W/RLS CAP
 28" WHITE PINE N5°E 5.6'
 18" WHITE PINE S60°W 35.2'</p> <p>SET 4" CEDAR POST W/LOC TAG
 BY CORNER</p> | <p style="text-align: center;"><u>3, W.C. N89°06'10" E 45.22' FROM 3</u></p> <p>SET 5/8" ROD W/RLS CAP
 6" B. ASH N1°E 12.4'
 7" CEDAR EAST 55.7'</p> <p>SET 4" SQ. CEDAR POST W/LOC TAG
 BY CORNER</p> |
|---|---|

SIGNED BY *Kenneth J. Ostling*
 SURVEYOR'S MICHIGAN REGISTRATION NO. 10068

DATE 10

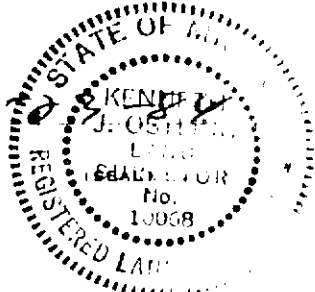

FOR STATE AND UNITED STATES AGENCIES:

SIGNED BY _____
 CHIEF OF SURVEY PARTY

DATE _____

APPROVED AND SIGNED BY _____ DATE _____
 MICHIGAN REGISTERED LAND SURVEYOR

SURVEYOR'S MICHIGAN REGISTRATION NO. _____ OSCODA COUNTY