

COUNTY OF OSCODA
 COMMISSION
 1995

LAND CORNER RECORDATION CERTIFICATE
 Filing Requirement of Act 74, Mich. P.A. 1970

For corners in OSCODA
 Oscoda
 (County)

Located In:

Corner Code #

Liber 4 pg. 6

1. Public Land Survey	T	<u>26N</u>	R	<u>2E</u>	<u>A - 6</u>
	T		R		
	T		R		
	T		R		
2. Property Controlling in Section	S		T		
	S		T		
3. Miscellaneous Property in Section	S		T		
	S		T		

STATE OF MICHIGAN
 OSCODA COUNTY
 FILED

2 AUG 95 9:35 A.M.

PATSY J. PETERS
 REGISTER OF DEEDS

Register of Deeds Stamp & File Number

4. Lot No. _____, Recorded Plat _____
 5. Private Claims _____

I, Marvin E. Myers, in a field survey on May 19, 19 95, do hereby certify that under requirements of P.A. 74, Michigan P.A. of 1970, the corner points mentioned in lines 1 and 2 above were in conformance with regulations and rules therefore as required in the current manual of survey instructions of the United States Department of the Interior, Bureau of Land Management or by a decree of a Court of Law and/or that the corner points mentioned in lines 3, 4 and 5 above were in conformance with the rules of the Michigan Board of Professional Surveyors or by a Decree of a Court of Law; established, re-established, monumented, re-monumented, recovered, found as expressed below:

NOTE: Not more than 4 corners, all in the same town and range, may be recorded on this certificate.

A. Description of original monument and accessories and/or subsequent restoration:

GLO-L. Clawson 1839
 Mon-Post
 WIT: 8" Aspen S62°W 44 lks.
 7" Aspen N85°W 24 lks.

Randall Feb. 1893
 Mon-Unknown
 WIT: None given

C.O. Seeley Sept. 21, 1914
 Mon-Set Post
 WIT: NBT 12" Soft Maple S66°E 0.39 lks.
 NBT 10" Water Elm S21°W 1.08 3/4 lks.

GLO-G. Veal Oct. 1935
 Mon-Set Conc. Mon. with
 Brass Tablet by proportionate distance
 WIT: 4" Birch S56°E 19 lks.
 4" Elm N83½°W 62½ lks.
 Fence N. 12 lks. & E. 2 lks.

G. Henning 1953
 Mon-Fd. US GLO Mon.
 WIT: NBT Spike 10" J.Pine N40½°E 47.00'
 NBT Spike 7" J.Pine S21°W 51.20'

G. Henning Aug. 1956
 Mon-Broken off
 WIT: US 6" Birch S56°E 12.50'
 BT 16" Maple S29°W 52.50'
 BT 8" Maple N47°E 44.80'

L.2, pg.170 N. Caldwell July 28, 1
 Mon-Unknown
 WIT: ½" Bar & Cap N88 3/4"E 33.00'
 LCRC L.3, pg.90
 L.4, pg.489 N. Caldwell July 16, 1
 Mon-Fd. 6" Dia. Conc. Mon. replace
 with USFS 5"x5"x36" Conc. Mon.
 WIT: ½" Rerod N87°W 33.00'
 ½" Rerod & Cap #12018 N89°E
 33.20'
 Power Pole N24°W 69.25'
 8" Maple S35°E 25.85'

A	B	C	D	E	F	G	H	I	J	K	L
2	6	5	4	3	2						
3											
4	7	8	9	10	11	12					
5											
6	18	17	16	15	14	13					
7											
8	19	20	21	22	23	24					
9											
10	30	29	28	27	26	25					
11											
12	31	32	33	34	35	36					
13											

B. Description of corner evidence found and/or method applied in restoring or reestablishing corner:

Found USFS 5"x5" Concrete Monument. Accepted as a careful and faithful establishment of the position of the corner.


APPROVED

County Remonumentation
 Peer Review Group

*NCC/31/95
 JULY*

C. Description of monument for corner and accessories established to perpetuate locating the position of the corner:

Mon-USFS 5"x5" Conc. Mon.
 WIT: ½" Rerod N87°W 33.00'
 ½" Rerod & Cap #12018 N89°E 33.20'
 Power Pole N24°W 69.25'
 8" Maple S35°E 25.85'

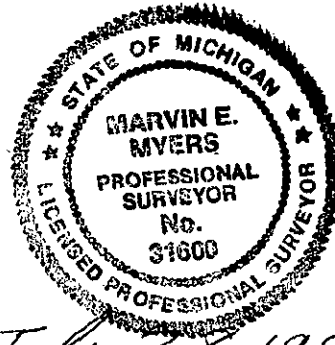

Signed by Marvin E. Myers

Date July 28, 1995

Surveyor's Michigan License No. 31600