


LAND CORNER RECORDATION CERTIFICATE
Filing Requirement of Act 74, Mich. P.A. 1970

Liber 4 pg 71

For corners in Oscoda <small>(County)</small>	Located In:	Corner Code #
1. Public Land Survey	T <u>26N</u> R <u>2E</u>	<u>B - 7</u>
	T _____ R _____	_____
	T _____ R _____	_____
	T _____ R _____	_____
2. Property Controlling in Section	S _____ T _____ R _____	_____
	S _____ T _____ R _____	_____
3. Miscellaneous Property in Section	S _____ T _____ R _____	_____
	S _____ T _____ R _____	_____

STATE OF MICHIGAN
 OSCODA COUNTY
 FILED
 2 AUG 95 9:38 A.M.
 PATSY J. PETERS
 REGISTER OF DEEDS
 Register of Deeds Stamp & File Number

4. Lot No. _____, Recorded Plat _____
 5. Private Claims _____

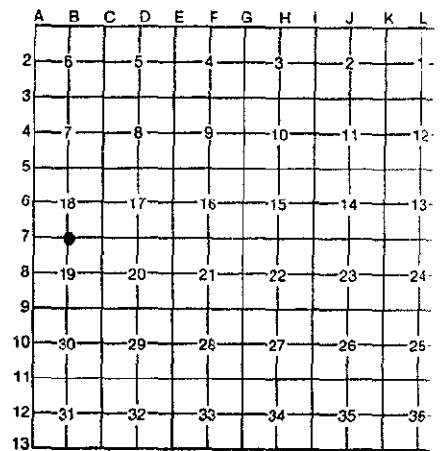

I, Marvin E. Myers, in a field survey on July 19, 19 95, do hereby certify that under requirements of P.A. 74, Michigan P.A. of 1970, the corner points mentioned in lines 1 and 2 above were in conformance with regulations and rules therefore as required in the current manual of survey instructions of the United States Department of the Interior, Bureau of Land Management or by a decree of a Court of Law and/or that the corner points mentioned in lines 3, 4 and 5 above were in conformance with the rules of the Michigan Board of Professional Surveyors or by a Decree of a Court of Law; established, re-established, monumented, re-monumented, recovered, found as expressed below:

NOTE: Not more than 4 corners, all in the same town and range, may be recorded on this certificate.

A. Description of original monument and accessories and/or subsequent restoration:

- | | | |
|--|---|---|
| GLO-W. Coon July 1839
Mon-Post
WIT: 12" Aspen N04°W 15 lks.
16" Aspen S37½°E 3 lks. | E.Lucus Date Unknown
Mon-US GLO Std. Mon.
WIT: None given | L,2, pg.170 N. Caldwell July 1975
Mon-Unknown
WIT: None given |
| John Randall Dec. 28, 1887
Mon-Fd. stake & both US
Bearing Trees
WIT: 16" W.Pine N40°E 9½ lks. | C.O. Seeley Sept. 23, 1914
Mon-Set ¼ Post
WIT: NBT 12" W.Pine stump S61°E 1.09 chs. | L.4, pg.489 N. Caldwell July 1990
Mon-6" Conc. Mon.
WIT: 12" Apple Tree S01°E 60.03'
12" Tw. Birch Stump N08°E 49.63'
7" J.Pine S22°W 28.92'
15" W.Pine N42°W 40.59' |
| US GLO-G. Veal Oct. 1935
Mon-Accept intersection of road
& fence Set US GLO Conc. Mon.
with Brass Tablet
WIT: 8" Dbl. Birch N08½°E 75½ lks.
10" Norway S23°E 313 lks. | L.2, pg.115 N. Caldwell April 23, 1969
Mon-Fd. US GLO Mon. & 1" Bar
WIT: 12" Apple S01°W 60.20'
4" W.Pine N49°W 48.70'
20" Tw. Birch N06°E 50.00'
½" Bar (local cor.) S80°E 10.90' | LCRC L.3, pg.92 N. Caldwell Oct. 1990
Mon-6" Conc. Mon.
WIT: 12" Apple Tree S01°E 60.03'
12" Tw. Birch Stump N08°E 49.63'
7" J.Pine S22°W 28.92'
15" W.Pine N42°W 40.59' |
| 1958 N. Caldwell MSHD
Mon-Fd. 1935 USGLO 6" Conc. Mon.
WIT: Telephone Pole S75°W 47.33'
Corner fence post N12°W 86.83'
16" Oak N83°E 56.05' | L.1, pg.117 N. Caldwell Sept. 1971
Mon-None given
WIT: None given(field notes in file) | LCRC L.2, pg.115
Mon-GLO Mon. & 1" Bar
WIT: 12" Apple S01°W 60.16'
4" W.Pine N49°W 48.73'
20" Tw. Birch N06°E 50.03'
½" Rod (local cor.) S80°E 10.89' |

B. Description of corner evidence found and/or method applied in restoring or reestablishing corner:

US GLO Concrete Monument. Accepted as the best available evidence of the re-establishment of the original corner.

C. Description of monument for corner and accessories established to perpetuate locating the position of the corner:

- Mon-US GLO Conc. Mon. with Brass Cap
 WIT: 12" Apple Tree S01°E 60.03'
 12" Tw. Birch Stump N08°E 49.63'
 7" J.Pine S22°W 28.92'
 15" W.Pine N42°W 40.59'
 L.4, pg. 489 USFS
 Lat 44°38'16" .35592
 Long 84°14'30" .00828

APPROVED
 County Remonumentation
 Peer Review Group

NCC/31/AUG 95
 JULY



Signed by Marvin E. Myers Date July 28, 1995