

**SURVEY & REMONUMENTATION**

SEP 29 1994

COMMISSION

**LAND CORNER RECORDATION CERTIFICATE**  
**Filing Requirement of Act 74, Mich. P.A. 1970**

L 3 Pg 270

For corners in

Oscoda (County)	Located In:	Corner Code #
1. Public Land Survey	T <u>26N</u> R <u>2E</u>	<u>C - 5</u>
	T _____ R _____	_____
	T _____ R _____	_____
	T _____ R _____	_____
2. Property Controlling in Section	S _____ T _____ R _____	_____
	S _____ T _____ R _____	_____
3. Miscellaneous Property in Sec.	S _____ T _____ R _____	_____
	S _____ T _____ R _____	_____
4. Lot No. _____, Recorded Plat _____		
5. Private Claims _____		

STATE OF MICHIGAN  
 OSCODA COUNTY  
 FILED

14 SEP 94 11:05 A.M.

PATSY J. PETERS  
 REGISTER OF DEEDS

Register of Deeds Stamp & File Number

I, Marvin E. Myers, in a field survey on July 7, 1994, do hereby certify that under requirements of P.A. 74, Michigan P.A. of 1970, the corner points mentioned in lines 1 and 2 above were in conformance with regulations and rules therefore as required in the current manual of survey instructions of the United States Department of the Interior, Bureau of Land Management or by a decree of a Court of Law and/or that the corner points mentioned in lines 3, 4 and 5 above were in conformance with the rules of the Michigan Board of Land Surveyors or by a Decree of a Court of Law; established, re-established, monumented, re-monumented, recovered, found as expressed below:

	A	B	C	D	E	F	G	H	I	J	K	L	M
2	6		5		4		3		2				
3													
4	7		8		9		10		11		12		
5													
6	18		17		16		15		14		13		
7													
8	19		20		21		22		23		24		
9													
10	30		29		28		27		26		25		
11													
12	31		32		33		34		35		36		
13													

**NOTE: Not more than 4 corners, all in the same town and range, may be recorded on this certificate.**

**A. Description of original monument and accessories and/or subsequent restoration:**

GLO-July 1839 Coon Mon-Post WIT: 18" J.Pine S45½°W 14 lks. 25" W.Pine N69°E 11 lks.	GLO-1935 Guy Veal Mon-3½" Brass Tablet in 6" Conc. Mon. WIT: 6" B.Oak N86°E 84 lks. 16" Poplar S30½E 168 lks.	L.3, pg.92 LCRC July 1990 N.Caldwell Mon-5/8" Bar LS #12018 Cap in Mon Box WIT: P.Pole S24°W 34.55' P.Pole S57°W 53.84' Anchor Post N39°W 67.97' 24" B.Oak N88°E 55.66'
Sept. 1885 J.Randall Mon-Unknown 1960 Oscoda County Road Comm. Plans Mon-Unknown Corner at Station 103+89.7 N-S Road at Station 104+08.0	Consumers Power Co. File Mon-GLO Mon & Fence Post WIT: Fence cor. N12°W 86.83' 16" Oak N83°E 56.05' Telephone Pole S75°W 47.33'	July 1990 N. Caldwell Mon- 5/8" rebar & cap Wit-Same as above.

**B. Description of corner evidence found and/or method applied in restoring or reestablishing corner:**

Found 5/8" Bar & Cap LS #12018 in Mon. Box 18'± west of centerline of Mapes Road and 2'± South of centerline of Brown Cabin Road and is accepted as a careful and faithful reestablishment of the position of the original corner.


**APPROVED**

County Remonumentation  
 Peer Review Group

*NCC*  
*27 AUG 94*

**C. Description of monument for corner and accessories established to perpetuate locating the position of the corner:**

Mon - 5/8" Bar & Cap with LS #12018 in Mon. Box  
 WIT: Power Pole S24°W 34.55'  
 Power Pole S57°W 53.84'  
 Anchor Post N39°W 67.97'  
 24" B.Oak N88°E 55.66'

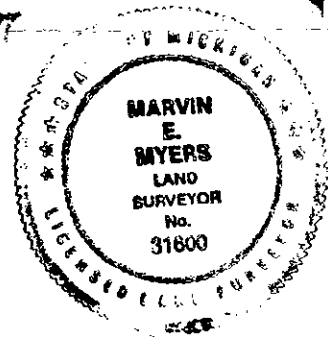

Signed by Marvin E. Myers Date Aug 23, 1994  
 Surveyor's Michigan License No. 31600