

**SURVEY &
REMONUMENTATION**

SEP 29 1994

COMMISSION

LAND CORNER RECORDATION CERTIFICATE
Filing Requirement of Act 74, Mich. P.A. 1970

L 3 Pg 271

STATE OF MICHIGAN
OSCODA COUNTY
FILED

14 SEP 94 11:05 A.M.

PATSY J. PETERS
REGISTER OF DEEDS

For corners in

Oscoda (County)	Located In:	Corner Code #
1. Public Land Survey	T 26N R 2E	C - 6
	T _____ R _____	_____
	T _____ R _____	_____
	T _____ R _____	_____
2. Property Controlling in Section	S _____ T _____ R _____	_____
	S _____ T _____ R _____	_____
3. Miscellaneous Property in Sec.	S _____ T _____ R _____	_____
	S _____ T _____ R _____	_____
4. Lot No. _____, Recorded Plat _____		
5. Private Claims _____		

Register of Deeds Stamp & File Number

	A	B	C	D	E	F	G	H	I	J	K	L	M
2	6	5	4	3	2	1							
3													
4	7	8	9	10	11	12							
5													
6	18	17	16	15	14	13							
7													
8	19	20	21	22	23	24							
9													
10	30	29	28	27	26	25							
11													
12	31	32	33	34	35	36							
13													

I, Marvin E. Myers, in a field survey on July 7, 19 94, do hereby certify that under requirements of P.A. 74, Michigan P.A. of 1970, the corner points mentioned in lines 1 and 2 above were in conformance with regulations and rules therefore as required in the current manual of survey instructions of the United States Department of the Interior, Bureau of Land Management or by a decree of a Court of Law and/or that the corner points mentioned in lines 3, 4 and 5 above were in conformance with the rules of the Michigan Board of Land Surveyors or by a Decree of a Court of Law; established, re-established, monumented, re-monumented, recovered, found as expressed below:

NOTE: Not more than 4 corners, all in the same town and range, may be recorded on this certificate.

A. Description of original monument and accessories and/or subsequent restoration:

- GLO-July 1839 Coon
Mon-Post
WIT: 4" Aspen N16°W 20 lks.
3" Aspen S20½°E 10 lks.
- May 1914 C.O. Seeley
Mon-Set Post
WIT: NBT 6" Spruce S63°E 1.12½ chs.
- GLO-1935 Guy Veal
Mon-Fd. Seeley Post
Set 3½" Brass Tablet in 6" Conc. Mon.
WIT: 10" J.Pine S62½°E 110½ lks.
14" B.Oak S77½°W 193 lks.
Cor. is 0.65' West of intersection of Roads N-S & E-W
- 1958 Consumers Power Co. File
(MSHD 1958 MRW)
Mon-GLO Mon
WIT: SW Cor. Gas Station N34°W 93.12'
SE Cor. Gas Station N23°W 76.68'
Power Pole N62°E 119.26'
- LCRC L.2, pg.113 April 1969 N.Caldwell
Mon-US GLO Mon.
WIT: SW Cor. Gas Station N34°W 93.10'
SE Cor. Gas Station N23°W 76.70'
- LCRC L.3, pg.93 Oct. 1990 N.Caldwell
Mon-6" Conc. Mon with 3½" Brass Tablet
WIT: Power Pole S43°W 63.54'
Power Pole N59°E 119.30'
SE Cor. Conc. Block Bldg. N22°W 76.64'
"4" Chiseled in Conc. Abuttment S01°E 38.90'
- L.4, pg.76 Feb. 1986 F.King
Mon-Fd. Mon. Box
WIT: See L.2, pg.113
- L.4, pg.489 July 1990 N.Caldwell
Mon-See L.3, pg.93
WIT: See L.3, pg. 93
- 1960 Oscoda County Road Plans
Mon-Unknown
WIT: C N-S Road East 23.50'
In C Road E-W
At Station 130+57.0

B. Description of corner evidence found and/or method applied in restoring or reestablishing corner.


Monument found US GLO Monument in Mon. Box verified position by measurement to accessories of record and is accepted as a careful and faithful reestablishment of the position of the original corner.

APPROVED
County Remonumentation
Peer Review Group

NEC
27 AUG 94

C. Description of monument for corner and accessories established to perpetuate locating the position of the corner:

- Mon-US GLO 6" Concrete Monument with 3½" Dia. Brass Tablet in Mon. Box 20'± West of C Mapes Road
70'± North of C M-72 in C Gorton Road
- WIT: Power Pole S43°W 63.54'
Power Pole N59°E 119.30'
SE Cor. Conc. Block Bldg. N22°W 76.64'
SW Cor. Conc. Block Bldg. N34°W 93.10'
"4" Chiseled in conc. abuttment S01°E 38.90'

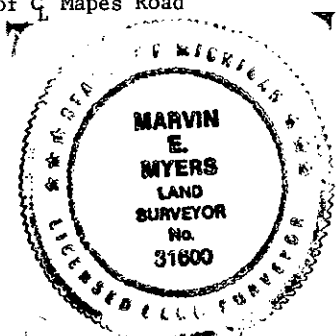

Signed by Marvin E. Myers Date Aug 23, 1994
Surveyor's Michigan License No. 31600