

# SURVEY & REMONUMENTATION

SEP 29 1994

## LAND CORNER RECORDATION CERTIFICATE Filing Requirement of Act 74, Mich. P.A. 1970

L 3 Pg 272

STATE OF MICHIGAN  
OSCODA COUNTY  
FILED

### COMMISSION

For corners in

Oscoda <small>(County)</small>	Located In:	Corner Code #	
1. Public Land Survey	T <u>26N</u> R <u>2E</u>	<u>C - 7</u>	
	T _____ R _____	_____	
	T _____ R _____	_____	
	T _____ R _____	_____	
2. Property Controlling in Section	S _____ T _____ R _____	_____	
	S _____ T _____ R _____	_____	
3. Miscellaneous Property in Sec.	S _____ T _____ R _____	_____	
	S _____ T _____ R _____	_____	
4. Lot No. _____, Recorded Plat _____			
5. Private Claims _____			

14 SEP 94 11:06 A.M.

PATSY J. PETERS  
REGISTER OF DEEDS

Register of Deeds Stamp & File Number

I, Marvin E. Myers, in a field survey on July 7, 19 94, do hereby certify that under requirements of P.A. 74, Michigan P.A. of 1970, the corner points mentioned in lines 1 and 2 above were in conformance with regulations and rules therefore as required in the current manual of survey instructions of the United States Department of the Interior, Bureau of Land Management or by a decree of a Court of Law and/or that the corner points mentioned in lines 3, 4 and 5 above were in conformance with the rules of the Michigan Board of Land Surveyors or by a Decree of a Court of Law; established, re-established, monumented, re-monumented, recovered, found as expressed below:

	A	B	C	D	E	F	G	H	I	J	K	L	M
2	6	5	4	3	2	1							
3													
4	7	8	9	10	11	12							
5													
6	18	17	16	15	14	13							
7													
8	19	20	21	22	23	24							
9													
10	30	29	28	27	26	25							
11													
12	31	32	33	34	35	36							
13													

**NOTE: Not more than 4 corners, all in the same town and range, may be recorded on this certificate.**

**A. Description of original monument and accessories and/or subsequent restoration:**

GLO-July 1839 Coon Mon-Post WIT: 18" Beech S21°E 27 lks. 20" Hemlock S61°W 34 lks.	GLO-1935 Guy Veal Mon-Fd. 1½" Pipe Set 3½" Brass Tablet in 6" Conc. Mon WIT: 14" Maple N29° 48½ lks. 8" Tw. Elm N56°W 50½ lks.	1960 Oscoda County Road Plans Mon-Unknown WIT: None given Corner is at Station 80+43.6
May 1914 C.O. Seeley Mon-Fd. US	Consumers Power Co. Files (MSHD 1958 MKW) Mon-Fd. 1½" Pipe & GLO Mon WIT: Steel Sign Post N41°E 51.25' Telephone Pole S35°W 53.95' 20" Tw. Elm N40°W 33.38'	

**B. Description of corner evidence found and/or method applied in restoring or reestablishing corner:**

Found 60D Spike inside ½" Pipe with part of yellow plastic cap in intersection of N-S & West roads on fence line East. Verified position by measurement to accessories of record. Guy Veal notes indicate that County Surveyor Randall found original and Guy Veal perpetuated this location, however, the County Surveyor was C.O. Seeley not Randall. Found ½"x12" Pipe with plastic cap below pipe were broken pieces of Guy Veal's concrete monument. Placed Standard Oscoda County Monument in Mon. Box.


**C. Description of monument for corner and accessories established to perpetuate locating the position of the corner:**

Mon- Std. Oscoda County Mon. in Mon. Box  
 WIT: 4" Polebarn Nail SW side Power Pole S28°E 101.35'  
 4" Polebarn Nail North side corner fence post East 33.55'  
 NE Cor. of Hse. #1510 S40°W 124.40'  
 Fd. Steel Fence Post N41°E 51.25'  
 4" Polebarn Nail South side Power Pole N45°W 46.10'

APPROVED

County Remonumentation  
Peer Review Group

M.E.M.  
27 AUG 94

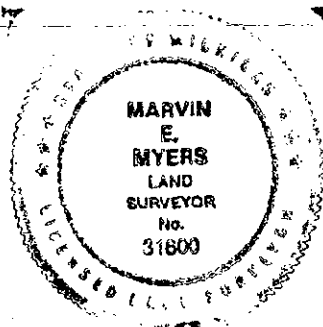

Signed by Marvin E. Myers

Date AUG 23, 1994

Surveyor's Michigan License No. 31600