

SURVEY &
REMONUMENTATION

SEP 29 1994

COMMISSION

LAND CORNER RECORDATION CERTIFICATE
Filing Requirement of Act 74, Mich. P.A. 1970

L 3 Pg 273

STATE OF MICHIGAN
OSCODA COUNTY
FILED

14 SEP 94 11:06 A.M.

PATSY J. PETERS
REGISTER OF DEEDS

For corners in

Oscoda (County)	Located In:	Corner Code #
1. Public Land Survey	T 26N R 2E	C - 8
	T _____ R _____	_____
	T _____ R _____	_____
	T _____ R _____	_____
2. Property Controlling in Section	S _____ T _____ R _____	_____
	S _____ T _____ R _____	_____
3. Miscellaneous Property in Sec.	S _____ T _____ R _____	_____
	S _____ T _____ R _____	_____
4. Lot No. _____, Recorded Plat _____		
5. Private Claims _____		

Register of Deeds Stamp & File Number

I, Marvin E. Myers, in a field survey on July 8, 19 94, do hereby certify that under requirements of P.A. 74, Michigan P.A. of 1970, the corner points mentioned in lines 1 and 2 above were in conformance with regulations and rules therefore as required in the current manual of survey instructions of the United States Department of the Interior, Bureau of Land Management or by a decree of a Court of Law and/or that the corner points mentioned in lines 3, 4 and 5 above were in conformance with the rules of the Michigan Board of Land Surveyors or by a Decree of a Court of Law; established, re-established, monumented, re-monumented, recovered, found as expressed below:

NOTE: Not more than 4 corners, all in the same town and range, may be recorded on this certificate.

A. Description of original monument and accessories and/or subsequent restoration:

GLO-July 1837 Coon Mon-Post WIT: 10" Y.Pine N33°W 17 lks. 8" W.Pine S12½°W 10 lks.	GLO-1935 Guy Veal Mon-3½" Brass Tablet in 6" Conc. Mon. WIT: 12" Norway S77°E 45 lks. 8" B.Oak N12°W 169 lks. Near west edge road Veal set monument from bearing tree marked by Randall	April 14, 1959 G.D.Henning Mon-US Mon WIT: Tag in 12" Box Elder N61°W 136.60' ½"x36" Iron Bar East 75.00' 8" Norway S39°E 101.40' ½"x36" Iron Bar West 75.00'
Jan 1890 Randall Mon- Found U.S. Remarkd same Wit- 14" W. pine West 67 lks. 8" Y. Pine S78°E 44 lks. Both U.S. fully identified.		1960 Oscoda County Road Comm. Plans Mon-US GLO Monument WIT: None given Station 54+03.5

B. Description of corner evidence found and/or method applied in restoring or reestablishing corner:

Found ½" Bar & Cap at road surface verified position by measurement to accessories of record. Found 8" Dock spike over U.S. GLO monument and is accepted as a careful and faithful perpetuation of the position of the Original corner. Placed mon box around monument.


C. Description of monument for corner and accessories established to perpetuate locating the position of the corner:

Mon- U.S. GLO 6" diameter concrete monument with 3½" dia. brass cap in mon box.
WIT: Fd. ½" Bar & Cap #12018 East 75.00'
Fd. ½" Bar West 75.00'
Fd. 8" (now 12") Norway with GDH Nail & Tag, S39°E 101.40'
4" Polebarn Nail in North side 7" Norway N60°E 47.73'
21'± North of East - West fence lines

APPROVED

County Remonumentation
Peer Review Group

*NCC
27 AUG 94*

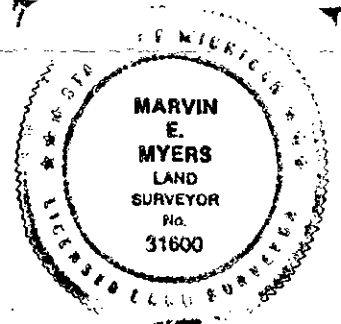

Signed by Marvin E. Myers Date Aug 24, 1994
Surveyor's Michigan License No. 31600