

**SURVEY &
REMONUMENTATION**

SEP 29 1994

COMMISSION

**LAND CORNER RECORDATION CERTIFICATE
Filing Requirement of Act 74, Mich. P.A. 1970**

STATE OF MICHIGAN
OSCODA COUNTY
FILED

14 SEP 94 11:06 A.M.

PATSY J. PETERS
REGISTER OF DEEDS

L3 Pg 274

Register of Deeds Stamp & File Number

For corners in

Oscoda (County)	Located In:	Corner Code #
1. Public Land Survey	T 26N R 2E	C - 9
	T R	
	T R	
	T R	
2. Property Controlling in Section	S T R	
	S T R	
3. Miscellaneous Property in Sec.	S T R	
	S T R	

4. Lot No. _____, Recorded Plat _____
5. Private Claims _____

I, Marvin E. Myers, in a field survey on July 7, 19 94, do hereby certify that under requirements of P.A. 74, Michigan P.A. of 1970, the corner points mentioned in lines 1 and 2 above were in conformance with regulations and rules therefore as required in the current manual of survey instructions of the United States Department of the Interior, Bureau of Land Management or by a decree of a Court of Law and/or that the corner points mentioned in lines 3, 4 and 5 above were in conformance with the rules of the Michigan Board of Land Surveyors or by a Decree of a Court of Law; established, re-established, monumented, re-monumented, recovered, found as expressed below:

NOTE: Not more than 4 corners, all in the same town and range, may be recorded on this certificate.

A. Description of original monument and accessories and/or subsequent restoration:

GLO-July 1839 Coon
Mon-Post
WIT: 8" Spruce Pine S63°E 75 lks.
4" Spruce Pine N52°W 33 lks.

GLO-Oct. 1935 Guy Veal
Mon-Fd. 1" Pipe Set in 3 1/2" Brass
Tablet in 6" Conc. Mon.
WIT: 13" J.Pine N26°E 77 1/2 lks.
14" B.Oak S60 1/2°E 117 lks.
7" J.Pine S70 3/4°W 145 1/2 lks.
14" J.Pine N09 1/2°W 129 1/2 lks.

L.1, pg.37 Dec.1972 N.Caldwell
Mon-3/4" Pipe from GLO B.T.
WIT: J.Pine (GLO) S71°W 96.00'
10" J.Pine N40°E 82.15'
10" J.Pine N65°W 49.00'

April 1911 C.O.Seeley
Mon-Found Original

April 14, 1959 G.D.Henning
Mon-1"x8" Pin over US GLO Mon.
WIT: 10" J.Pine N54°W 106.95'
Tag 8" J.Pine N42°E 82.60'
Tag 8" J.Pine S42°E 104.60'
Tag 12" J.Pine S70°W 95.30'

1960 Oscoda County Road Comm. Plans
Mon-Iron Pipe at Station 26+73.3
WIT: None given

B. Description of corner evidence found and/or method applied in restoring or reestablishing corner:

Found 1/2" Bar and Cap in intersection of roads North - South and East - West. Verified position by measurement to accessories of record and is accepted as a careful and faithful perpetuation of the position of the original corner. Found U.S. GLO MONUMENT with 1/2"x12" pipe and cap over top.


APPROVED

County Remonumentation
Peer Review Group

*NCC
27 AUG 94*

C. Description of monument for corner and accessories established to perpetuate locating the position of the corner:

Mon - Set std. Oscoda County monument in mon box over top of U.S. GLO monument.
WIT: Fd. 12" J.Pine Stump S42°E 104.60'
Fd. 12" J.Pine with G.D.Henning Tag N42°E 82.60'
Set 4" Pole Barn Nail North Side Power Pole S50°W 73.84'
Fd. 12" J.Pine Stump S70°W 95.30'
4" Pole Barn Nail SW Side Power Pole N55°W 72.65'
In Center of Road intersection N-S-E-W.

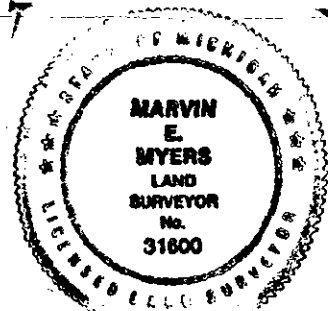

Signed by Marvin E. Myers

Date Aug 25, 1994

Surveyor's Michigan License No. 31600