

**SURVEY &
REMONUMENTATION**

MAR 1 9 1997

COMMISSION

LAND CORNER RECORDATION CERTIFICATE
Filing Requirement of Act 74, Mich. P.A. 1970

For corners in <u>Oscoda</u> (County)	Located in:	Corner Code #
1. Public Land Survey	T <u>26N</u> R <u>2E</u>	<u>D - 1</u>
	T _____ R _____	_____
	T _____ R _____	_____
	T _____ R _____	_____
2. Property Controlling in Section	S _____ T _____ R _____	_____
	S _____ T _____ R _____	_____
3. Miscellaneous Property in Section	S _____ T _____ R _____	_____
	S _____ T _____ R _____	_____
4. Lot No. _____, Recorded Plat _____		
5. Private Claims _____		

Liber 4 pg 135

STATE OF MICHIGAN
OSCODA COUNTY
FILED

26 NOV 96 2:45 P.M.

PATSY J. PETERS
REGISTER OF DEEDS

Register of Deeds Stamp & File Number

I, Marvin E. Myers, in a field survey on June 27, 19 96,
do hereby certify that under requirements of P.A. 74, Michigan P.A. of 1970, the corner points mentioned
in lines 1 and 2 above were in conformance with regulations and rules therefore as required in the current
manual of survey instructions of the United States Department of the Interior, Bureau of Land
Management or by a decree of a Court of Law and/or that the corner points mentioned in lines 3, 4 and
5 above were in conformance with the rules of the Michigan Board of Professional Surveyors or by a
Decree of a Court of Law; established, re-established, monumented, re-monumented, recovered, found
as expressed below:

NOTE: Not more than 4 corners, all in the same town and range, may be recorded
on this certificate.

A. Description of original monument and accessories and/or subsequent restoration:

GLO - 1935 Guy Veal Mon. - Set at proportionate distance based on township plat Brass Tablet in 6" conc. mon. WIT: 6" Norway S37½°E 14½ lks. 6" Poplar S26 3/4°W 34½ lks.	Liber 3, pg. 422 Edwin T. McComb Oct. 1979 Mon.-Pd. Guy Veal mon. WIT: 14" N.Pine NE 15.45' 14" N.Pine SE 9.68' 10" N.Pine NW 26.52' S½ Sec. 32
---	---

Not set by original

B. Description of corner evidence found and/or method applied in restoring or reestablishing corner:

Found brass tablet in 6" concrete
Found 6" Norway S37½°E 15½ lks.
Found all accessories recorded in Liber 3, page 422
This position not established by original government survey.
This monument is accepted as a careful and faithful determination of the position of the corner.
Closing North ½ Corner, T26N, R2E

C. Description of monument for corner and accessories established to perpetuate locating the position of the corner:


Found U.S. GLO concrete monument with Brass Cap, left in place
WIT: 8" Norway nail N. side N50°E 13.71'
Set nail above over grown nail S. side 15" Norway N65°W 26.52'
Nail SW side 7" Norway S55°E 13.23'
Nail side 4" W.Pine N20°W 19.41'

A	B	C	D	E	F	G	H	I	J	K	L	M
2	6	5	4	3	2	1						
3												
4	7	8	9	10	11	12						
5												
6	18	17	16	15	14	13						
7												
8	19	20	21	22	23	24						
9												
10	30	29	28	27	26	25						
11												
12	31	32	33	34	35	36						
13												

APPROVED

County Remonumentation
Peer Review Group

*NEC
16 NOV 96*

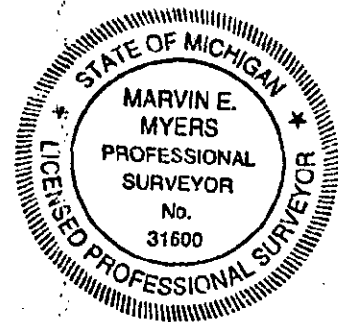

Signed by Marvin E. Myers
Surveyor's Michigan License No. 31600

Date SEP 7 1996