

SURVEY & REMONUMENTATION

SEP 29 1994

COMMISSION

LAND CORNER RECORDATION CERTIFICATE
Filing Requirement of Act 74, Mich. P.A. 1970

L3 Pg 279

For corners in

Oscoda (County)	Located In:	Corner Code -#
1. Public Land Survey	T <u>26N</u> R <u>2E</u>	<u>D - 5</u>
	T _____ R _____	_____
	T _____ R _____	_____
	T _____ R _____	_____
2. Property Controlling in Section	S _____ T _____ R _____	_____
	S _____ T _____ R _____	_____
3. Miscellaneous Property in Sec.	S _____ T _____ R _____	_____
	S _____ T _____ R _____	_____

STATE OF MICHIGAN
 OSCODA COUNTY
 FILED

14 SEP 94 11:07 A.M.

PATSY J. PETERS
 REGISTER OF DEEDS

Register of Deeds Stamp & File Number

4. Lot No. _____, Recorded Plat _____
 5. Private Claims _____

I, Marvin E. Myers, in a field survey on July 12, 19 94, do hereby certify that under requirements of P.A. 74, Michigan P.A. of 1970, the corner points mentioned in lines 1 and 2 above were in conformance with regulations and rules therefore as required in the current manual of survey instructions of the United States Department of the Interior, Bureau of Land Management or by a decree of a Court of Law and/or that the corner points mentioned in lines 3, 4 and 5 above were in conformance with the rules of the Michigan Board of Land Surveyors or by a Decree of a Court of Law; established, re-established, monumented, re-monumented, recovered, found as expressed below:

	A	B	C	D	E	F	G	H	I	J	K	L	M
2	6	5	4	3	2	1							
3													
4	7	8	9	10	11	12							
5													
6	18	17	16	15	14	13							
7													
8	19	20	21	22	23	24							
9													
10	30	29	28	27	26	25							
11													
12	31	32	33	34	35	36							
13													

NOTE: Not more than 4 corners, all in the same town and range, may be recorded on this certificate.

A. Description of original monument and accessories and/or subsequent restoration:

GLO-July 1839 Coon
 Mon-Post
 WIT: 20" Spruce Pine S21½°W 18 lks.
 4" Spruce Pine N43½°E 11 lks.

GLO 1935 Guy Veal
 Mon-3½" Brass Tablet in 6" Conc. Mon.
 WIT: 12" Norway N47½°E 279 lks.
 6" B.Oak S73 3/4°W 74 lks.

L.2, pg.111 1964 N. Caldwell
 Mon-Fd. US GLO Mon.
 WIT: 24" N.Pine N48°E 184.10'
 14" Oak S74°W 48.80'

B. Description of corner evidence found and/or method applied in restoring or reestablishing corner:

Found US GLO 6" Dia. Concrete Monument with 3½" Dia. Brass Table verified position by measurement to accessories of record and is accepted as a careful and faithful reestablishment of the position of the original corner.


APPROVED

County Remonumentation
 Peer Review Group

NCC
27 AUG 94

C. Description of monument for corner and accessories established to perpetuate locating the position of the corner:

Mon-US GLO 6" Concrete Monument with 3½" Dia. Brass Tablet Set ½"x18" Rebar along N. side for magnetic attraction
 WIT: Nail S. Side 11" R.Pine N87°W 45.82'
 Nail E. side 8" J.Pine S17°W 18.29'
 Nail S. side 6" J.Pine N84°E 21.57'
 Nail E. side 6" J.Pine N05°W 17.34'
 Fd. 12" (now 22") Norway N47½°E(R) N55°E(M) 184.18'
 Fd. 6" (now 16") B.Oak S73 3/4°W(R) S80°W(M). 48.84'

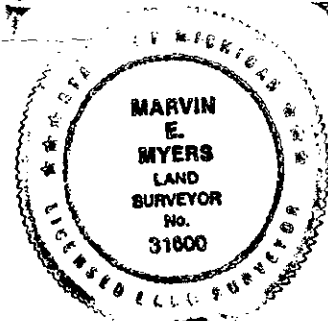

Signed by Marvin E. Myers

Date AUG 23, 1994

Surveyor's Michigan License No. 31600