

# SURVEY & REMONUMENTATION

SEP 29 1994

## LAND CORNER RECORDATION CERTIFICATE Filing Requirement of Act 74, Mich. P.A. 1970

L 3 Pg 281

STATE OF MICHIGAN  
OSCODA COUNTY  
FILED

For corners in **COMMISSION**

14 SEP 94 11:08 A.M.

PATSY J. PETERS  
REGISTER OF DEEDS

Oscoda <small>(County)</small>	Located In:	Corner Code <del>##</del>	
1. Public Land Survey	T <u>26N</u> R <u>2E</u>	<u>D - 9</u>	
	T _____ R _____	_____	
	T _____ R _____	_____	
	T _____ R _____	_____	
2. Property Controlling in Section	S _____ T _____ R _____	_____	
	S _____ T _____ R _____	_____	
3. Miscellaneous Property in Sec.	S _____ T _____ R _____	_____	
	S _____ T _____ R _____	_____	

Register of Deeds Stamp & File Number

4. Lot No. \_\_\_\_\_, Recorded Plat \_\_\_\_\_  
5. Private Claims \_\_\_\_\_

	A	B	C	D	E	F	G	H	I	J	K	L	M
2	6	5	4	3	2	1							
3													
4	7	8	9	10	11	12							
5													
6	18	17	16	15	14	13							
7													
8	19	20	21	22	23	24							
9													
10	30	29	28	27	26	25							
11													
12	31	32	33	34	35	36							
13													

I, Marvin E. Myers, in a field survey on July 8, 19 94, do hereby certify that under requirements of P.A. 74, Michigan P.A. of 1970, the corner points mentioned in lines 1 and 2 above were in conformance with regulations and rules therefore as required in the current manual of survey instructions of the United States Department of the Interior, Bureau of Land Management or by a decree of a Court of Law and/or that the corner points mentioned in lines 3, 4 and 5 above were in conformance with the rules of the Michigan Board of Land Surveyors or by a Decree of a Court of Law; established, re-established, monumented, re-monumented, recovered, found as expressed below:

**NOTE: Not more than 4 corners, all in the same town and range, may be recorded on this certificate.**

**A. Description of original monument and accessories and/or subsequent restoration:**

GLO-July 1839 Coon Mon-Post WIT: 18" Y.Pine N71°W 11 lks. 3" Dwarf Oak S87°E 21 lks.	L.1, pg.37 Dec. 1972 N.Caldwell Mon-Pd. GLO Mon in Centerline E-W Road WIT: RR Spike in top of GLO Stump N61°W 63.10' Power Pole S70°W 96.30' Large Fence Post N10°E 34.00' Set 1" Pipe along Side Mon. Power Pole S60°E 84.60'
GLO-Oct. 1935 Guy Veal Mon-3½" Brass Tablet in 6" Conc. Mon. WIT: 6" J.Pine S50°W 64 lks. 9" B.Oak N61°W 96 lks.	L.2, pg.129 N.Caldwell Same as L.1, pg. 37
July 1964 N.Caldwell Mon-US GLO Mon. No accessories noted.	

**B. Description of corner evidence found and/or method applied in restoring or reestablishing corner:**

Found GLO 6" Concrete Monument with 1" Pipe along East side of Monument and the GLO 6" Concrete Monument is accepted as a careful and faithful reestablishment of the position of the original corner.


## APPROVED

County Remonumentation  
Peer Review Group

NCC  
 27 AUG 94

**C. Description of monument for corner and accessories established to perpetuate locating the position of the corner:**

Mon-6" Concrete US GLO Monument with 3½" Dia. Brass Tablet  
 WIT: 1" Pipe along East side  
 Set 4" Pole Barn nail in SW side 7" Norway N30°W 38.42'  
 Fd. USFS Post N05°E 33.00'  
 Fd. Large Fence Post N17°E 34.00'  
 Face of Power Pole S54°E (recorded as S60°E) 84.60'  
 Face of Power Pole S81°W (recorded as S70°W) 96.30'

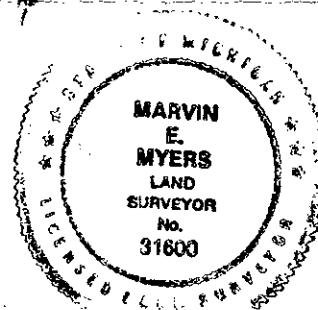

Signed by Marvin E. Myers Date Aug 23, 1994  
 Surveyor's Michigan License No. 31600