

# SURVEY & REMONUMENTATION

SEP 29 1994

COMMISSION

## LAND CORNER RECORDATION CERTIFICATE Filing Requirement of Act 74, Mich. P.A. 1970

L. 3 Pg 283

For corners in

Oscoda (County)	Located In:	Corner Code #
1. Public Land Survey	T <u>26N</u> R <u>2E</u>	<u>E-2</u>
	T _____ R _____	_____
	T _____ R _____	_____
	T _____ R _____	_____
2. Property Controlling in Section	S _____ T _____ R _____	_____
	S _____ T _____ R _____	_____
3. Miscellaneous Property in Sec.	S _____ T _____ R _____	_____
	S _____ T _____ R _____	_____

STATE OF MICHIGAN  
OSCODA COUNTY  
FILED

14 SEP 94 11:08 A.M.

PATSY J. PETERS  
REGISTER OF DEEDS

Register of Deeds Stamp & File Number

4. Lot No. \_\_\_\_\_, Recorded Plat \_\_\_\_\_  
5. Private Claims \_\_\_\_\_

	A	B	C	D	E	F	G	H	I	J	K	L	M
2	6	5	4	3	2	1							
3													
4	7	8	9	10	11	12							
5													
6	18	17	16	15	14	13							
7													
8	19	20	21	22	23	24							
9													
10	30	29	28	27	26	25							
11													
12	31	32	33	34	35	36							
13													

I, Marvin E. Myers, in a field survey on July 12, 19 94, do hereby certify that under requirements of P.A. 74, Michigan P.A. of 1970, the corner points mentioned in lines 1 and 2 above were in conformance with regulations and rules therefore as required in the current manual of survey instructions of the United States Department of the Interior, Bureau of Land Management or by a decree of a Court of Law and/or that the corner points mentioned in lines 3, 4 and 5 above were in conformance with the rules of the Michigan Board of Land Surveyors or by a Decree of a Court of Law; established, re-established, monumented, re-monumented, recovered, found as expressed below.

**NOTE: Not more than 4 corners, all in the same town and range, may be recorded on this certificate.**

**A. Description of original monument and accessories and/or subsequent restoration:**

GLO-July 1839 Coon Mon-Post WIT: 8" Spruce N27½°E 14 lks. 10" Spruce S34 3/4°W 16 lks.	1908-1909 Fargo Survey, Mon-Unknown WIT: 20" W.Pine Stump N52°E 55½ lks. 16" W.Pine S54°W 53 lks. (stump had been marked before)	GLO-Oct 1935 Guy Veal Mon-1" Iron Post in 6" Conc. WIT: Tw. 8" B.Oak N27°E 105 lks. 15" Norway S59½°E 171 lks. Located ½" Pipe S69°W 14 lks.
Feb. 1888 J.Randall Mon-Not Given WIT: Not Given	Oct. 1915 Fargo Topo Survey Mon-Unknown, Corner position reestablished by Fargo (C.P.O. CO) WIT: Same as 1908-09 Survey Feb. 1924 G.F.Delamater	May 1940 G.D.Henning Mon-GLO Mon. Conc. with Brass Tablet WIT: 15" Norway S59½°E 171 lks. 8" Tw. B.Oak N27°E 105 lks.

**B. Description of corner evidence found and/or method applied in restoring or reestablishing corner.**


Found both US GLO BT. Found remains of concrete monument at intersection of BT's reestablished corner monument at intersection and accepted as a careful and faithful reestablishment of the position of the original corner.

**APPROVED**  
County Remonumentation  
Peer Review Group

*NCC*  
*27 AUG 94*

**C. Description of monument for corner and accessories established to perpetuate locating the position of the corner:**

Mon-Set Std. Oscoda County Monument  
WIT: Fd. US GLO 15" Norway S59½°E (now 22" S52°E) 112.86'  
Fd. Nail in Red Tag in E. face, removed tag & set 4" polebarn nail in same nail hole, 9" Norway S17°W 5.20'  
Fd. US GLO 8" Tw.B.Oak N27°E (now 15" N30°E) 69.30'  
Set 4" Polebarn Nail W. side 7" Norway N18°W 52.79'  
Set Nail S. side 12" Tw.B.Oak N77°E 68.52'  
N20°E 23'± intersection of trail road

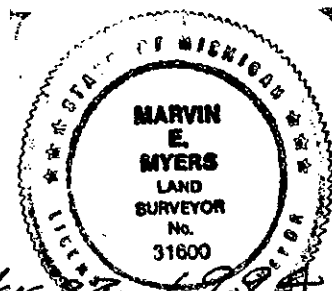

Signed by Marvin E. Myers  
Surveyor's Michigan License No. 31600

Date Aug 23, 1994