

**SURVEY &
REMONUMENTATION**

SEP 29 1994

COMMISSION

LAND CORNER RECORDATION CERTIFICATE
Filing Requirement of Act 74, Mich. P.A. 1970

L 3 pg 284

STATE OF MICHIGAN
OSCODA COUNTY
FILED

14 SEP 94 11:08 A.M.


PATSY J. PETERS
REGISTER OF DEEDS

For corners in

| Oscoda (County) | Located In: | Corner Code # |
|---------------------------------------|-------------------------|---------------|
| 1. Public Land Survey | T 26N R 2E | E-3 |
| | T _____ R _____ | _____ |
| | T _____ R _____ | _____ |
| | T _____ R _____ | _____ |
| 2. Property Controlling in Section | S _____ T _____ R _____ | _____ |
| | S _____ T _____ R _____ | _____ |
| 3. Miscellaneous Property in Sec. | S _____ T _____ R _____ | _____ |
| | S _____ T _____ R _____ | _____ |

Register of Deeds Stamp & File Number

4. Lot No. _____, Recorded Plat _____
5. Private Claims _____

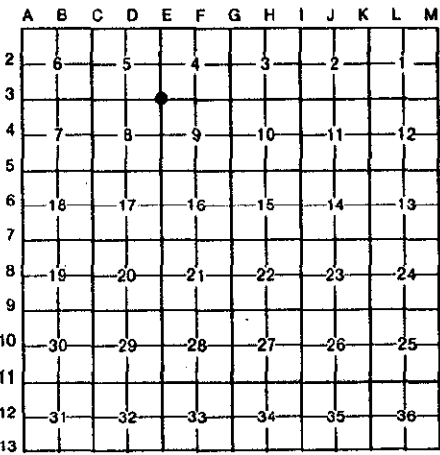

I, Marvin E. Myers, in a field survey on July 13, 19 94, do hereby certify that under requirements of P.A. 74, Michigan P.A. of 1970, the corner points mentioned in lines 1 and 2 above were in conformance with regulations and rules therefore as required in the current manual of survey instructions of the United States Department of the Interior, Bureau of Land Management or by a decree of a Court of Law and/or that the corner points mentioned in lines 3, 4 and 5 above were in conformance with the rules of the Michigan Board of Land Surveyors or by a Decree of a Court of Law; established, re-established, monumented, re-monumented, recovered, found as expressed below:

NOTE: Not more than 4 corners, all in the same town and range, may be recorded on this certificate.

A. Description of original monument and accessories and/or subsequent restoration:

- | | |
|---|---|
| GLO-July 1839 Coon Mon-Post WIT: 18" Spruce Pine S02°E 18 lks. 12" Spruce Pine N74°W 10 lks. | GLO-Oct 1935 Guy Veal Mon-Fd. Post Set 3½" Dia. Brass Tablet in Conc. |
| 1908-1909 Fargo Eng. (C.P.CO.) Mon-Post Fd. WIT: Fd. Tamarck in place of Spruce Pine marks plain | WIT: 18" dead Tamarack S02°E 18 lks. (with scribe marks- record call for Spruce Pine Tree) 8" crooked Cedar N34½°E 19 lks. 7" Cedar S63½°E 10½ lks. 7" Balsam S15½°W 22 lks. 6" Cedar N84½°W 19½ lks. |
| 1924 Record G.F.Delamater | |

Consumers Power Co. Files
Mon-Fd.

1948 Valley Vista Plat G.Henning
Mon-Unknown
WIT: Conc. Mon. S00°47'E 871.60'

B. Description of corner evidence found and/or method applied in restoring or reestablishing corner:

Found US GLO 6" Concrete Monument with 3½" Dia. Brass Tablet verified position by measurements to accessories to record and is accepted as a careful and faithful perpetuation of the position of the original corner.

APPROVED

County Remonumentation
Peer Review Group

NCC
27 AUG 94

C. Description of monument for corner and accessories established to perpetuate locating the position of the corner:

- Mon-Fd. GLO Mon. (Steel fence Post SE side; single wire running West)
WIT: Fd. 13" Cedar with Blaze N34°E 12.19'
Fd. Cedar with Blaze S67°E 6.96'
Fd. Balsam Stump S21°W 14.09'
Set Nail S. side 8" Tamarack West 33.64'
Set Nail E. side 8" Cedar S23°W 8.62'
Set Nail NE side 7" Cedar S30°E 11.99'
Set Nail S. side 11" Cedar N69°E 36.84'
Set ½"x36" Bar on S. side of Mon. for magnetic attraction



Signed by Marvin E. Myers

Date Aug 23, 1994

Surveyor's Michigan License No. 31600