

**SURVEY &  
REMONUMENTATION**

SEP 29 1994

COMMISSION

**LAND CORNER RECORDATION CERTIFICATE  
Filing Requirement of Act 74, Mich. P.A. 1970**

L 3 pg 285

For corners in

Oscoda _____ (County)	Located In:	Corner Code #
1. Public Land Survey	T <u>26N</u> R <u>2E</u>	<u>E - 4</u>
	T _____ R _____	_____
	T _____ R _____	_____
	T _____ R _____	_____
2. Property Controlling in Section	S _____ T _____ R _____	_____
	S _____ T _____ R _____	_____
3. Miscellaneous Property in Sec.	S _____ T _____ R _____	_____
	S _____ T _____ R _____	_____

STATE OF MICHIGAN  
OSCODA COUNTY  
FILED

14 SEP 94 11:09 A.M.

PATSY J. PETERS  
REGISTER OF DEEDS

Register of Deeds Stamp & File Number

4. Lot No. \_\_\_\_\_, Recorded Plat \_\_\_\_\_  
5. Private Claims \_\_\_\_\_

	A	B	C	D	E	F	G	H	I	J	K	L	M
2	6	5	4	3	2	1							
3													
4	7	8	9	10	11	12							
5													
6	18	17	16	15	14	13							
7													
8	19	20	21	22	23	24							
9													
10	30	29	28	27	26	25							
11													
12	31	32	33	34	35	36							
13													

I, Marvin E. Myers, in a field survey on July 11, 19 94, do hereby certify that under requirements of P.A. 74, Michigan P.A. of 1970, the corner points mentioned in lines 1 and 2 above were in conformance with regulations and rules therefore as required in the current manual of survey instructions of the United States Department of the Interior, Bureau of Land Management or by a decree of a Court of Law and/or that the corner points mentioned in lines 3, 4 and 5 above were in conformance with the rules of the Michigan Board of Land Surveyors or by a Decree of a Court of Law; established, re-established, monumented, re-monumented, recovered, found as expressed below:

**NOTE: Not more than 4 corners, all in the same town and range, may be recorded on this certificate.**

**A. Description of original monument and accessories and/or subsequent restoration:**

GLO-July 1839 Coon Mon-Post WIT: 6" Spruce Pine N71°E 15½ lks. 5" Spruce Pine S59½°W 14 lks.	GLO-Oct. 1935 Guy Veal Mon-3½" Brass Tablet in Conc. WIT: 12" J.Pine S17½°E 103 lks. 12" J.Pine N46½°W 41 lks.	April 1969 N. Caldwell Mon-Fd. USGLO Mon. WIT: J.Pine Stump S18°E 60.00' 14" J.Pine N46°W 27.10' 6" J.Pine N70°E 2.60' 8" J.Pine S15°E 8.50'
---	---	---

**B. Description of corner evidence found and/or method applied in restoring or reestablishing corner:**

Found US GLO 6" Concrete Monument with 3½" Brass Tablet verified position by measurement to accessories of record and is accepted as a careful and faithful reestablishment of the position of the original corner.


**APPROVED**

County Remonumentation  
Peer Review Group

*NCC  
27 AUG 94*

**C. Description of monument for corner and accessories established to perpetuate locating the position of the corner:**

Mon-Fd. GLO Mon. 6" Concrete Mon with 3½" Dia. Brass Tablet (fence cor. 3.85' South fence N & E)  
WIT: Nail S. side 4" J.Pine S76°W 23.25'  
Nail E. side 5" J.Pine South 18.78'  
Nail SE side 11" J.Pine N56°E 19.65'  
Nail SW side 8" J.Pine N32°W 38.73'  
Fd. 12" J.Pine (dead) N46½°W 27.06'

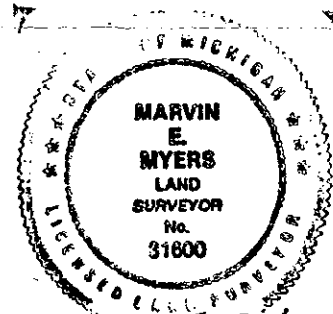

Signed by

*Marvin E. Myers*

Date

*AUG 23, 1994*

Surveyor's Michigan License No.

31600