

**SURVEY &  
REMONUMENTATION**

SEP 29 1994

COMMISSIONER

**LAND CORNER RECORDATION CERTIFICATE  
Filing Requirement of Act 74, Mich. P.A. 1970**

L 3 Pg 289

STATE OF MICHIGAN  
OSCODA COUNTY  
FILED

14 SEP 94 11:10 A.M.

PATSY J. PETERS  
REGISTER OF DEEDS

For corners in

Oscoda (County)	Located In:	Corner Code #
1. Public Land Survey	T 26N R 2E	E - 8
	T _____ R _____	_____
	T _____ R _____	_____
	T _____ R _____	_____
2. Property Controlling in Section	S _____ T _____ R _____	_____
	S _____ T _____ R _____	_____
3. Miscellaneous Property in Sec.	S _____ T _____ R _____	_____
	S _____ T _____ R _____	_____

Register of Deeds Stamp & File Number

4. Lot No. \_\_\_\_\_, Recorded Plat \_\_\_\_\_  
5. Private Claims \_\_\_\_\_

I, Marvin E. Myers, in a field survey on July 8, 1994, do hereby certify that under requirements of P.A. 74, Michigan P.A. of 1970, the corner points mentioned in lines 1 and 2 above were in conformance with regulations and rules therefore as required in the current manual of survey instructions of the United States Department of the Interior, Bureau of Land Management or by a decree of a Court of Law and/or that the corner points mentioned in lines 3, 4 and 5 above were in conformance with the rules of the Michigan Board of Land Surveyors or by a Decree of a Court of Law; established, re-established, monumented, re-monumented, recovered, found as expressed below:

	A	B	C	D	E	F	G	H	I	J	K	L	M
2	6	5	4	3	2	1							
3													
4	7	8	9	10	11	12							
5													
6	13	17	16	15	14	13							
7													
8	19	20	21	22	23	24							
9													
10	30	29	28	27	26	25							
11													
12	31	32	33	34	35	36							
13													

**NOTE: Not more than 4 corners, all in the same town and range, may be recorded on this certificate.**

**A. Description of original monument and accessories and/or subsequent restoration:**

GLO-July 1839 Coon Mon-Post WIT: 8" W. Birch North 10 lks. 10" Aspen N65 3/4°E 15 lks.	May 1914 C.O. Seeley Mon-Post by John Randall remarked WIT: 20" W. Pine S22 1/2°E 38 1/2 lks. 20" Tamarack N17°E 34 lks. (dead & gone)	GLO-1935 Guy Veal Mon-Fd. Randall cor. set 3 1/2" Brass Tablet in Conc. Mon. WIT: 16" W. Pine Stump N32°E 19 lks. 6" Poplar N64 1/2°W 123 1/2 lks.
Dec. 1887 J. Randall Mon-Remarkd Post Fd. GLO stake WIT: Fd. US BT 8" W. Birch West 10 lks. NBT 14" W. Pine N32°E 19 lks.		

**B. Description of corner evidence found and/or method applied in restoring or reestablishing corner:**

Found 6" Concrete Monument with 3 1/2" Dia. Brass Tablet and is accepted as a careful and faithful perpetuation of the position of the original corner.


**APPROVED**

County Remonumentation  
Peer Review Group

*NEC  
27 AUG 94*

**C. Description of monument for corner and accessories established to perpetuate locating the position of the corner:**

Mon-6" Conc. Mon. with 3 1/2" Dia. Brass Tablet placed several 4" Pole Barn Nails around edge of Mon. for magnetic attraction Mon. is 2'± North of intersection of fence line N-S & E-W in fence row.  
WIT: 4" Pole Barn Nail in N. side 4" Poplar S70°W 4.00'  
4" Pole Barn Nail in E. side 4" Poplar N06°W 19.58'  
4" Pole Barn Nail in SE side 10" Balsam S20°W 18.75'  
4" Pole Barn Nail in SW 7" Balsam S55°E 19.17'

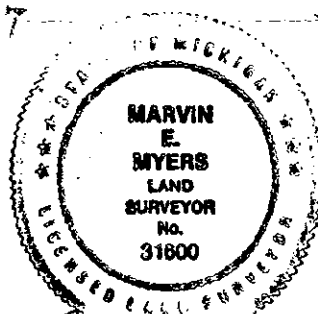

Signed by Marvin E. Myers  
Surveyor's Michigan License No. 31600

Date Aug 23, 1994