

**SURVEY &  
REMONUMENTATION**

SEP 29 1994

COMMISSION

**LAND CORNER RECORDATION CERTIFICATE  
Filing Requirement of Act 74, Mich. P.A. 1970**

L 3 pg. 290

For corners in

Oscoda (County)	Located In:	Corner Code #
1. Public Land Survey	T 26N R 2E	E - 9
	T _____ R _____	_____
	T _____ R _____	_____
	T _____ R _____	_____
2. Property Controlling in Section	S _____ T _____ R _____	_____
	S _____ T _____ R _____	_____
3. Miscellaneous Property in Sec.	S _____ T _____ R _____	_____
	S _____ T _____ R _____	_____

STATE OF MICHIGAN  
OSCODA COUNTY  
FILED  
14 SEP 94 11:10 A.M.  
PATSY J. PETERS  
REGISTER OF DEEDS

Register of Deeds Stamp & File Number

4. Lot No. \_\_\_\_\_, Recorded Plat \_\_\_\_\_  
5. Private Claims \_\_\_\_\_

	A	B	C	D	E	F	G	H	I	J	K	L	M
2	6		5		4		3		2				
3													
4	7		8		9		10		11		12		
5													
6	18		17		16		15		14		13		
7													
8	19		20		21		22		23		24		
9													
10	30		29		28		27		26		25		
11													
12	31		32		33		34		35		36		
13													

I, Marvin E. Myers, in a field survey on July 8, 19 94, do hereby certify that under requirements of P.A. 74, Michigan P.A. of 1970, the corner points mentioned in lines 1 and 2 above were in conformance with regulations and rules therefore as required in the current manual of survey instructions of the United States Department of the Interior, Bureau of Land Management or by a decree of a Court of Law and/or that the corner points mentioned in lines 3, 4 and 5 above were in conformance with the rules of the Michigan Board of Land Surveyors or by a Decree of a Court of Law; established, re-established, monumented, re-monumented, recovered, found as expressed below:

**NOTE: Not more than 4 corners, all in the same town and range, may be recorded on this certificate.**

**A. Description of original monument and accessories and/or subsequent restoration:**

GLO-July 1839 Coon Mon-Post WIT: 12" Aspen S09°E 22 lks. 10" Aspen N14°W 15 lks.	GLO 1935 Guy Veal Mon-Fd. 1" Pipe Replaced with Std. 3/4" Brass Tablet in Conc. Mon. WIT: E-W Road South 44 lks. No suitable accessories available	1964 N. Caldwell Mon-Fd. US GLO Mon. No accessories available
-------------------------------------------------------------------------------------------	---	---------------------------------------------------------------------

**B. Description of corner evidence found and/or method applied in restoring or reestablishing corner:**


Monument found US GLO Monument and accepted as the best available evidence of the position of the original corner.

**APPROVED**  
County Remonumentation  
Peer Review Group

*NCC*  
*27 AUG 94*

**C. Description of monument for corner and accessories established to perpetuate locating the position of the corner:**

Mon-US GLO 6" Dia. Conc. Mon. with 3 1/2" Dia. Brass Tablet with 1" Pipe 0.6' South of corner for magnetic attraction  
WIT: Set 4" Polebarn Nail in West side 7" Apple Tree N30°E 40.60'  
Fd. face of USFS location post N08°E 33.00'  
Face of Power Pole S52°E 67.30'  
Set 4" Polebarn Nail SW side Fence Post N37°W 46.04'

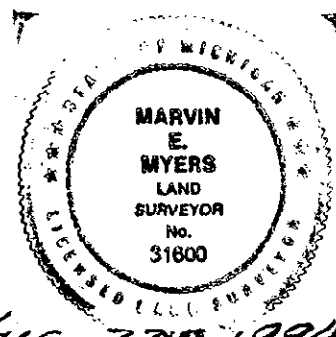

Signed by Marvin E. Myers  
Surveyor's Michigan License No. 31600

Date AUG 23, 1994