

SURVEY & REMONUMENTATION

SEP 29 1994

COMMISSION

LAND CORNER RECORDATION CERTIFICATE
Filing Requirement of Act 74, Mich. P.A. 1970

L3 pg 291

For corners in

Oscoda <small>(County)</small>	Located In:	Corner Code ##	
1. Public Land Survey	T 26N R 2E	E - 10	
	T _____ R _____	_____	
	T _____ R _____	_____	
	T _____ R _____	_____	
2. Property Controlling in Section	S _____ T _____ R _____	_____	
	S _____ T _____ R _____	_____	
3. Miscellaneous Property in Sec.	S _____ T _____ R _____	_____	
	S _____ T _____ R _____	_____	

STATE OF MICHIGAN
OSCODA COUNTY
FILED

14 SEP 94 11:10 A.M.

PATSY J. PETERS
REGISTER OF DEEDS

Register of Deeds Stamp & File Number

4. Lot No. _____, Recorded Plat _____
5. Private Claims _____

I, Marvin E. Myers, in a field survey on July 8, 19 94, do hereby certify that under requirements of P.A. 74, Michigan P.A. of 1970, the corner points mentioned in lines 1 and 2 above were in conformance with regulations and rules therefore as required in the current manual of survey instructions of the United States Department of the Interior, Bureau of Land Management or by a decree of a Court of Law and/or that the corner points mentioned in lines 3, 4 and 5 above were in conformance with the rules of the Michigan Board of Land Surveyors or by a Decree of a Court of Law; established, re-established, monumented, re-monumented, recovered, found as expressed below:

NOTE: Not more than 4 corners, all in the same town and range, may be recorded on this certificate.

	A	B	C	D	E	F	G	H	I	J	K	L	M
2	6	5	4	3	2	1							
3													
4	7	8	9	10	11	12							
5													
6	18	17	16	15	14	13							
7													
8	19	20	21	22	23	24							
9													
10	30	29	28	27	26	25							
11													
12	31	32	33	34	35	36							
13													

A. Description of original monument and accessories and/or subsequent restoration:

GLO-July 1839 Coon Mon-Post WIT: 10" Spruce Pine N47°W 8 lks. 14" Spruce Pine S37°E 24 lks.	July 1964 N.Caldwell Mon-US GLO LCRC L.2, pg.130 Apr. 1969 N.Caldwell Mon-US GLO Mon in C E-W roadway with fences N-S WIT: 14" J.Pine N25°W 37.55' Power Pole N30°E 54.60'
April 1911 C.O.Seeley Mon-Post WIT: NBT 8" Spruce N27°W 18½ lks.	LCRC L.1, pg.37 Dec. 1972 N. Caldwell Mon-US GLO MON in E-W Road on N-S fence WIT: 14" J.Pine N25°W 37.55' Power Pole N30°E 54.60' Corner Fence Post South 23.40'
May 1934 G.D.Henning Mon-Angle iron WIT: NBT 4" J.Pine N22°E 1.42½ chs. NBT 14" Norway S65°W 1.56 chs. GLO-1935 Guy Veal	L/L, pg. 400 Nov. 1973 N.Caldwell Mon-Fd. GLO Conc. Mon. WIT: Fence Cor. South 24.00' ½" Bar & Cap south 33.00' Fence Cor. North 24.00' ½" Bar & Cap North 33.00'
Mon-3½" Dia. Brass Tablet in 6"x24" Conc. Mon. WIT: 8" B.Oak S17 3/4°E 138 lks. In Fence N-S 2 lks. N. of 3"x3" Post Apparently local cor.	

B. Description of corner evidence found and/or method applied in restoring or reestablishing corner.


Found US GLO 6" Concrete Monument with 3½" Brass Tablet. Verified position by measurements to accessories of record and is accepted as a careful and faithful reestablishment of the position of the original corner.
NOTE: April 1911 Seeley reestablished corner position by proparate measurement; May 1934 G. Henning found and perpetuated the same with angle iron; 1935 Guy Veal did not accept the Henning corner and reestablished the corner position by proparate measurement.

C. Description of monument for corner and accessories established to perpetuate locating the position of the corner:

Mon-US GLO 6" Concrete Monument with 3½" Brass Tablet
WIT: Fd. Steel Fence Post along South edge of mon. 0.40 for magnetic attraction
Fd. Power Pole N30°E 54.65'
Fd. Corner Fence Post South 23.40'
Set 4" Polebarn Nail in top center of Telephone Pedestal Support Post N25°E 26.50'
Face of Steel Satellite Antenna Post N40°W 83.65'
Set 4" Polebarn Nail NW side 4" J.Pine S45°W 45.85'
Face of USFS location Post South 26.70'

APPROVED

County Remonumentation
Peer Review Group

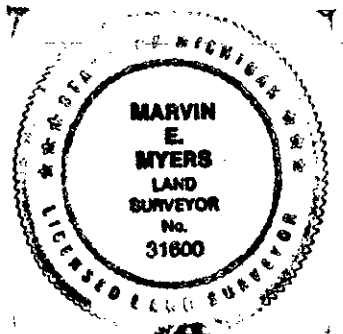

Signed by Marvin E. Myers

Date AUG 23, 1994

Surveyor's Michigan License No. 31600