

SURVEY & REMONUMENTATION

SEP 29 1994

COMMISSION

LAND CORNER RECORDATION CERTIFICATE
Filing Requirement of Act 74, Mich. P.A. 1970

L. 3 pg 292

STATE OF MICHIGAN
OSCODA COUNTY
FILED

14 SEP 94 11:10 A.M.

PATSY J. PETERS
REGISTER OF DEEDS

For corners in

Oscoda <small>(County)</small>	Located In:	Corner Code #
1. Public Land Survey	T <u>26N</u> R <u>2E</u>	<u>E - 11</u>
	T _____ R _____	_____
	T _____ R _____	_____
	T _____ R _____	_____
2. Property Controlling in Section	S _____ T _____ R _____	_____
	S _____ T _____ R _____	_____
3. Miscellaneous Property in Sec.	S _____ T _____ R _____	_____
	S _____ T _____ R _____	_____

Register of Deeds Stamp & File Number

4. Lot No. _____, Recorded Plat _____
5. Private Claims _____

I, Marvin E. Myers, in a field survey on July 11, 19 94, do hereby certify that under requirements of P.A. 74, Michigan P.A. of 1970, the corner points mentioned in lines 1 and 2 above were in conformance with regulations and rules therefore as required in the current manual of survey instructions of the United States Department of the Interior, Bureau of Land Management or by a decree of a Court of Law and/or that the corner points mentioned in lines 3, 4 and 5 above were in conformance with the rules of the Michigan Board of Land Surveyors or by a Decree of a Court of Law; established, re-established, monumented, re-monumented, recovered, found as expressed below:

NOTE: Not more than 4 corners, all in the same town and range, may be recorded on this certificate.

	A	B	C	D	E	F	G	H	I	J	K	L	M
2	6		5		4		3		2		1		
3													
4	7		8		9		10		11		12		
5													
6	18		17		16		15		14		13		
7													
8	19		20		21		22		23		24		
9													
10	30		29		28		27		26		25		
11					●								
12	31		32		33		34		35		36		
13													

A. Description of original monument and accessories and/or subsequent restoration:

GLO-July 1939 Coon
Mon-Post
WIT: 4" Spruce Pine N25°E 22½ lks.
4" Spruce Pine S16°W 20 lks.

April 1911 C.O. Seeley
Mon-Post from old BT
WIT: NBT 8" Spruce Pine N70½°E 70 lks.

GLO-1935 Guy Veal
Mon-Fd. C.O. Seeley 1½" Pipe
Replaced with 3½" Dia Brass Tablet
in 6" Conc. Cyl. 6"x24"
WIT: Fd. NBT Stump Hole N25°E 22½ lks.
Fd. 10" J.Pine N70°E 70 lks.
10" J.Pine N09½°E 146 lks.
4" J.Pine S34 3/4°E 66 lks.
5" J.Pine S44½°W 109 lks.
5" J.Pine N59½°W 81 lks.

L.1, pg. 400 Nov. 1973 N.Caldwell
Mon-GLO Conc. Mon
WIT: 8" J.Pine N60°E 17.45'
12" J.Pine S10°E 28.45'
12" J.Pine N64°W 53.00'

B. Description of corner evidence found and/or method applied in restoring or reestablishing corner:

Found US GLO 6" Concrete Monument with 3½" Dia. Brass Tablet, and is accepted as a careful and faithful perpetuation of the position of the original corner.


C. Description of monument for corner and accessories established to perpetuate locating the position of the corner:

Mon-GLO Mon. with 1" Pipe beside 2' Forest Service Marker Post lying on ground
WIT: Nail N side 7" Oak S45°E 10.50'
Nail E side 4" J.Pine S30°E 31.85'
Nail S side 3" J.Pine S65°W 19.11'
Nail NW side 7" Oak N19°E 16.63'

APPROVED

County Remonumentation
Peer Review Group

NCC
27 AUG 94

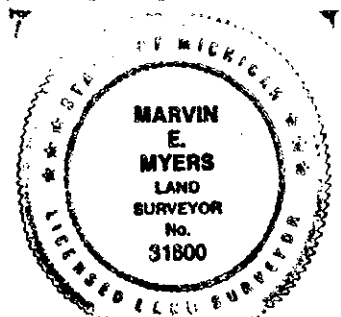

Signed by Marvin E. Myers

Date AUG 29, 1994

Surveyor's Michigan License No. 31600