

SURVEY & REMONUMENTATION

SEP 29 1994

LAND CORNER RECORDATION CERTIFICATE Filing Requirement of Act 74, Mich. P.A. 1970

L. 3 Pg 293

STATE OF MICHIGAN
OSCODA COUNTY
FILED

14 SEP 94 11:10 A.M.

PATSY J. PETERS
REGISTER OF DEEDS

For corners in **COMMISSION**

Oscoda <small>(County)</small>	Located In:	Corner Code #	
1. Public Land Survey	T 26N R 2E	E - 12	
	T _____ R _____	_____	
	T _____ R _____	_____	
	T _____ R _____	_____	
2. Property Controlling in Section	S _____ T _____ R _____	_____	
	S _____ T _____ R _____	_____	
3. Miscellaneous Property in Sec.	S _____ T _____ R _____	_____	
	S _____ T _____ R _____	_____	

Register of Deeds Stamp & File Number

4. Lot No. _____, Recorded Plat _____
5. Private Claims _____

I, Marvin E. Myers, in a field survey on July 8, 19 94, do hereby certify that under requirements of P.A. 74, Michigan P.A. of 1970, the corner points mentioned in lines 1 and 2 above were in conformance with regulations and rules therefore as required in the current manual of survey instructions of the United States Department of the Interior, Bureau of Land Management or by a decree of a Court of Law and/or that the corner points mentioned in lines 3, 4 and 5 above were in conformance with the rules of the Michigan Board of Land Surveyors or by a Decree of a Court of Law; established, re-established, monumented, re-monumented, recovered, found as expressed below:

NOTE: Not more than 4 corners, all in the same town and range, may be recorded on this certificate.

A. Description of original monument and accessories and/or subsequent restoration:

GLO-July 1839 Coon
Mon-Post
WIT: 10" Aspen S30 3/4°W 17 lks.
10" Spruce N20°W 12 lks.

Sept. 1914 C.O. Seeley
Mon-3/4"x24" Pipe
WIT: NBT 12" Y.Pine S47°W 1.36 1/2 lks.

GLO-1935 Guy Veal
Mon-3 1/2" Dia. Brass Tablet;
3" stem in 6" Dia.; 24" Long
Conc. Mon.
WIT: 6" Poplar N27 3/4°E 21 lks.
6" B.Oak N75 3/4°W 53 lks.

LCRC L.2, pg.234 Apr. 1969 N.Caldwell
Mon-Fd. US GLO Mon.
6' South of E-W Fence
41' East of N-S Fence
WIT: 8" N.Pine N60°W 22.10'

L.1, pg.241 Mar. 17, 1973 N.Caldwell
Mon-GLO Conc. Mon
WIT: Fence Cor. 6'N & 41'W
8" Norway N60°W 22.10'

	A	B	C	D	E	F	G	H	I	J	K	L	M
2	6	5	4	3	2	1							
3													
4	7	8	9	10	11	12							
5													
6	18	17	16	15	14	13							
7													
8	19	20	21	22	23	24							
9													
10	30	29	28	27	26	25							
11													
12	31	32	33	34	35	36							
13													

B. Description of corner evidence found and/or method applied in restoring or reestablishing corner:

Veal reestablished corner by proportionate measure.
Found US GLO 6" concrete monument verified position by measurement to accessories of record and is accepted as a careful and faithful reestablishment of the position of the original corner.


C. Description of monument for corner and accessories established to perpetuate locating the position of the corner:

Mon-US GLO 6" concrete monument with 3 1/2" Brass Tablet fd. 3/4" Pipe 1.5' deep S56°E 1.18'
WIT: Set 4" Polebarn Nail in E. side 4" R.Oak N25°W 10.81'
Set 4" Polebarn Nail in NW side 4" J.Pine S39°W 38.91'
Set 4" Polebarn Nail in North side 15" Large Tooth Poplar East 26.34'
Fd. 8" Norway Pine N60°W 22.10'

APPROVED

County Remonumentation
Peer Review Group

NCC
27 AUG 94

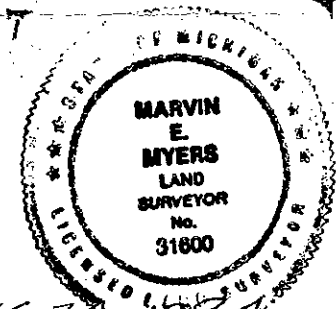

Signed by Marvin E. Myers Date AUG 24, 1994
Surveyor's Michigan License No. 31600