

**SURVEY & REMONUMENTATION**

MAR 19 1997

COMMISSION

**LAND CORNER RECORDATION CERTIFICATE**  
 Filing Requirement of Act 74, Mich. P.A. 1970

For corners in Oscoda <small>(County)</small>	Located In:	Corner Code #
1. Public Land Survey	T 26N R 2E	F - 1
	T _____ R _____	_____
	T _____ R _____	_____
	T _____ R _____	_____
2. Property Controlling in Section	S _____ T _____ R _____	_____
	S _____ T _____ R _____	_____
3. Miscellaneous Property in Section	S _____ T _____ R _____	_____
	S _____ T _____ R _____	_____
4. Lot No. _____, Recorded Plat _____		
5. Private Claims _____		

*Liber 4 pg 139*

STATE OF MICHIGAN  
 OSCODA COUNTY  
 FILED

26 NOV 96 2:47 P.M.

PATSY J. PETERS  
 REGISTER OF DEEDS

Register of Deeds Stamp & File Number

I, Marvin E. Myers, in a field survey on June 27, 19 96  
do hereby certify that under requirements of P.A. 74, Michigan P.A. of 1970, the corner points mentioned  
in lines 1 and 2 above were in conformance with regulations and rules therefore as required in the current  
manual of survey instructions of the United States Department of the Interior, Bureau of Land  
Management or by a decree of a Court of Law and/or that the corner points mentioned in lines 3, 4 and  
5 above were in conformance with the rules of the Michigan Board of Professional Surveyors or by a  
Decree of a Court of Law; established, re-established, monumented, re-monumented, recovered, found  
as expressed below:

**NOTE:** Not more than 4 corners, all in the same town and range, may be recorded  
on this certificate.

**A. Description of original monument and accessories and/or subsequent restoration:**  
 Not set in original survey  
 1908 Fargo Eng. May 15, 1940 G.D. Henning  
 Mon.-Set 1/2" gas pipe Mon.-US GLO  
 WIT: No BIs near WIT: None given

GLO 1935 Guy Veal  
 Mon.-3 1/2" brass tablet in 6"  
 conc. by proportionate distance  
 WIT: 8" Norway S12 1/2°E 51 1/2 lks.  
 9" Norway S57 1/2°W 94 lks.

**B. Description of corner evidence found and/or method applied in restoring or reestablishing corner:**


Found 1/2" bar in pavement box  
 This position not established by original government survey.  
 This monument is accepted as a careful and faithful determination  
 of the position of the corner  
 Closing Corner T26N, R2E

**APPROVED**  
 County Remonumentation  
 Peer Review Group

*NCC*  
*16 Nov 96*

**C. Description of monument for corner and accessories established to perpetuate locating the position of the corner:**

Replaced record 1/2" Bar with Standard Oscoda County Monument in pav't box  
 WIT: PK nail in top of guard rail post S66°W 35.02'  
 PK nail in top of guard rail post S40°E 25.45'  
 PK nail in top of guard rail post N43°W 30.35'  
 PK nail in top of guard rail post N62°E 33.04'

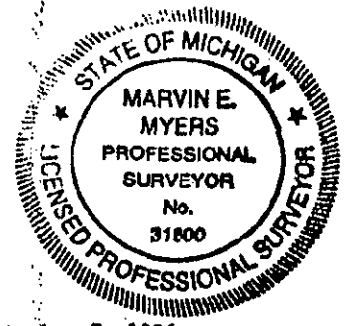

Signed by *Marvin E. Myers*  
 Surveyor's Michigan License No. 31600

Date September 7, 1996