

# SURVEY & REMONUMENTATION

APR 24 1995

COMMISSION

LAND CORNER RECORDATION CERTIFICATE  
Filing Requirement of Act 74, Mich. P.A. 1970

L. 4 Pg. 36

For corners in

OSCODA (County)	Located In:	Corner Code <del>##</del>
	BIG CREEK TWP.	
1. Public Land Survey	T 26N R 2E	G-7
	T _____ R _____	_____
	T _____ R _____	_____
	T _____ R _____	_____
2. Property Controlling in Section	S _____ T _____ R _____	_____
	S _____ T _____ R _____	_____
3. Miscellaneous Property in Sec.	S _____ T _____ R _____	_____
	S _____ T _____ R _____	_____

STATE OF MICHIGAN  
OSCODA COUNTY  
FILED


15 NOV 94 11:07 A.M.

PATSY J. PETERS  
REGISTER OF DEEDS

Register of Deeds Stamp & File Number

4. Lot No. \_\_\_\_\_, Recorded Plat **APPROVED**  
5. Private Claims \_\_\_\_\_

County Remonumentation Peer Review Group  
N.C.C. 8 Nov 94

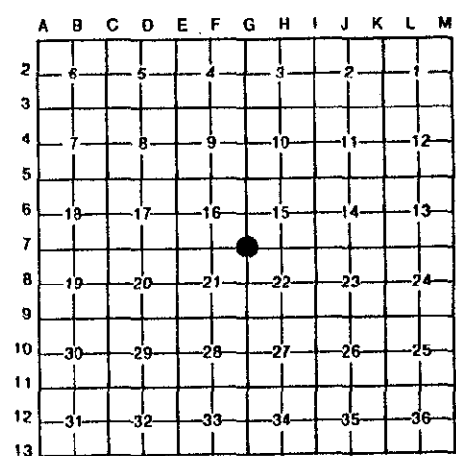

I, FREDERICK J. KING, in a field survey on October 6, 1994, do hereby certify that under requirements of P.A. 74, Michigan P.A. of 1970, the corner points mentioned in lines 1 and 2 above were in conformance with regulations and rules therefore as required in the current manual of survey instructions of the United States Department of the Interior, Bureau of Land Management or by a decree of a Court of Law and/or that the corner points mentioned in lines 3, 4 and 5 above were in conformance with the rules of the Michigan Board of Land Surveyors or by a Decree of a Court of Law; established, re-established, monumented, re-monumented, recovered, found as expressed below:

**NOTE: Not more than 4 corners, all in the same town and range, may be recorded on this certificate.**

A. Description of original monument and accessories and/or subsequent restoration:

- G-7 CORNER COMMON TO SECTIONS 1, 16, 21 & 22
- July 1839 - Original Post set by Lewis Clason, D.S. - - - - - N80W - Aspen - 7.92' (12 lks)  
On File - Reg of Deeds S64E - Cedar - 1.98' (3 1/2 lks)
  - 1935 - USGLO Mon set by Guy R. Veal, US Cad Eng - Set by Prop Meas - - - - - N52 1/2 E - Poplar - 34.98' (53 lks)  
No Orig Cor Evidence Fnd - On File - Reg of Deeds S75 1/4 E - Poplar - 27.39' (41 1/2 lks)  
S34 1/2 W - Poplar - 11.88' (18 lks)
  - May 1940 - US Post Fnd by George D. Henning, RLS - No Witnesses - Rec BK T26N-R2E
  - Sept 1940 - GLO Mon Fnd by George D. Henning, RLS - No Witnesses - Rec Bk T26N-R2E
  - May 1975 - Cor used by Norman C. Caldwell - No Corner Description - No Witnesses - Act 132 Rec L.2, Pg 166
  - Mar 1976 - Cor used by Norman C. Caldwell - No Corner Description - No Witnesses - Act 132 Rec L.2, Pg 325-326
  - Sept 1978 - GLO Mon Fnd by Norman C. Caldwell, RLS - - - - - In line with Fences N-S-W  
Act 132 Rec L.2, Pg. 545-546 S50W - 4" Spruce - 10.7' N85E - 4" Ash - 18.3'  
N45E - USFS Post - 1.0' South - Fnc Cor Post - 0.5'
  - Sept 1978 - ACT 74 Rec Bk 1, Pg 202 - By N.C. Caldwell, RLS - - - - - Fnd GLO Mon - Same Witness shown as Act 132 Rec L.2, Pg 545 -546

B. Description of corner evidence found and/or method applied in restoring or reestablishing corner:

- 10-6-94 - Found Rec USGLO Mon 0.5' NE of Fnc Cor Post - Iron Alongside  
Fences to North, South & West  
N45E - 1.4' (R-1.0') - USFS Post (78)  
S35W - (R-S50W)-10.2' (R-10.7') Fnd Spk NW sd 10" Spruce (78)  
S70W - 17.48' - Fnd Spk N sd 8" Spruce (Not Recorded)  
No 1839 or 1935 Witnesses Found

This Corner was approved by the Oscoda County Peer Review Comm., as a Careful and Faithful Establishment of the Position of the Corner, on November 1, 1994

C. Description of monument for corner and accessories established to perpetuate locating the position of the corner:

- 10-6-94 - Found USGLO Mon - 0.5' NE of Fnc Cor Post (Fnc - N-S-W) - Iron Alongside  
North - 12.54' - Set Tag in East sd 4" Ash  
N45E - 1.4' - (R-1.0') - Face of USFS Post  
N75E - 33.57' - Set Tag in South sd 5" Ash  
S35W - (R-S50W) - 10.15' (R-10.7') - Set Tag above Spk in NW sd 10" Spruce  
S70W - 17.48' - Set Tag above Fnd Spk in N sd 8" Spruce

NOTE: Witness BTs were marked with Db1 Headed Nails with I.D. Tag #25852



Signed by Frederick J. King Date 11-4-94  
Surveyor's Michigan License No. 25852