

# SURVEY & REMONUMENTATION

APR 24 1995

COMMISSION

LAND CORNER RECORDATION CERTIFICATE  
Filing Requirement of Act 74, Mich. P.A. 1970

L. 4 Pg. 38

For corners in

OSCODA (County)	Located In: BIG CREEK	Corner Code -##
1. Public Land Survey	T 26N R 2E	G-9
	T _____ R _____	_____
	T _____ R _____	_____
	T _____ R _____	_____
2. Property Controlling in Section	S _____ T _____ R _____	_____
	S _____ T _____ R _____	_____
3. Miscellaneous Property in Sec.	S _____ T _____ R _____	_____
	S _____ T _____ R _____	_____

STATE OF MICHIGAN  
OSCODA COUNTY  
FILED

15 NOV 94 11:07 A.M.

PATSY J. PETERS  
REGISTER OF DEEDS

Register of Deeds Stamp & File Number

4. Lot No. \_\_\_\_\_, Recorded Plat \_\_\_\_\_  
5. Private Claims \_\_\_\_\_

**APPROVED**

County Remonumentation  
Peer Review Group


*N 60 00 00 W  
4 NOV 94*

I, Frederick J. King, in a field survey on June 9, 1994, do hereby certify that under requirements of P.A. 74, Michigan P.A. of 1970, the corner points mentioned in lines 1 and 2 above were in conformance with regulations and rules therefore as required in the current manual of survey instructions of the United States Department of the Interior, Bureau of Land Management or by a decree of a Court of Law and/or that the corner points mentioned in lines 3, 4 and 5 above were in conformance with the rules of the Michigan Board of Land Surveyors or by a Decree of a Court of Law; established, re-established, monumented, re-monumented, recovered, found as expressed below:

**NOTE: Not more than 4 corners, all in the same town and range, may be recorded on this certificate.**

- A. Description of original monument and accessories and/or subsequent restoration:  
G-9 CORNER COMMON TO SECTIONS 21, 22, 27 & 28

July 1839 - Original Post set by Lewis Clason, D.S. - - - - -	S19W - Aspen - 3.96' (6 lks)
On File - Reg of Deeds	N50W - W Pine 1.98' (3 lks)
1935 - USGLO Mon set by Guy R. Veal, US Cad Eng - Set by Prop Meas - - -	N67E - Blk Oak - 36.93' (55 1/2 lks)
No Orig Cor Evidence Fnd - On File - Reg of Deeds	S64E - J Pine - 26.40' (40 lks)
	S66 1/2 W - J Pine - 2.97' (4 1/2 lks)
	N17'W - J Pine - 4.29' (6 1/2 lks)
May 1940 - US Post Fnd by George D. Henning, RLS - No Witnesses - Rec Bk T26N-R2E	
Sept 1940 - GLO Mon Fnd by George D. Henning, RLS - No Witnesses - Rec Bk T26N-R2E	
July 1964 - GLO Mon Fnd by Norman C. Caldwell, RLS - - - - -	N17W - J Pine - 3.9' (GLO BT)
Rec Bk T26N-R2E	S67W - J Pine - 3.0' (GLO BT)
	S64E - J Pine - 26.1' (GLO BT)
Aug 1964 - County Corner Registry - Rec Bk 2, Pg 128 - - - - -	Found FLO Mon
by N.C. Caldwell, RLS	N17W - 12" J Pine - 3.9'
Dec 1973 - Cor used by Norman C. Caldwell, RLS - No Cor Description	S67W - 6" J Pine - 3.0'
No Witnesses - Act 132 Rec L 1, Pg 436-437	S64E - 14" J Pine - 26.1'
Aug 1986 - GLO Mon Fnd by F.J. King, RLS - No Witnesses - Refers to	South- 110' to C.L. Pwr Line
Act 74 Rec Bk 2, Pg 128 - Act 132 - NOT RECORDED	

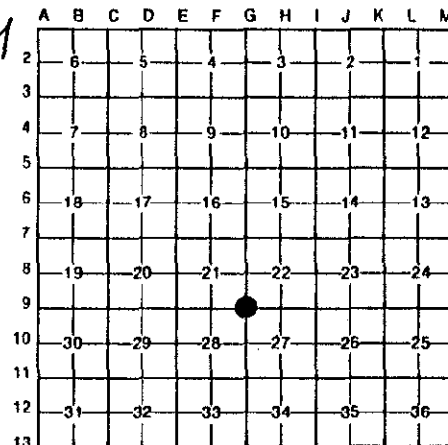

- B. Description of corner evidence found and/or method applied in restoring or reestablishing corner:

6-9-94 - Fnd Rec GLO Mon - - - N.67°E. - 36.93' - Fnd Rec BT (1935)  
with USFS Post S.64°E. - 26.1' - Fnd Rec BT (1935 & 1964) Now Stump  
0.6' E S.67°W. - 3.0' - Fnd Rec BT (1935 & 1964) Now Stump  
N.17°W. - 3.9' - Fnd Rec BT (1935 & 1964) Now Stump  
South - 110' - C.L. Pwr Line (1964)

No 1839 Wit Fnd

This Corner was Approved by the Oscoda County Peer Review Comm., as the Best available evidence of the Re-establishment of the Original Corner on July 15, 1994

- C. Description of monument for corner and accessories established to perpetuate locating the position of the corner:

Found Rec. USGLO Mon - Would not dip - Set I & C on S Side  
N.10°E. - 31.81' - Set Tag W sd 5" Elm  
N.75°E. (R-N67E) - 36.30' (R-36.93) Set Tag N sd 30" Oak  
S.70°E. - 0.85' - Set Tag S sd USFS Post  
S.64°E. - 26.1' - Rec J Pine (Now Stump)  
South - 110' - C.L. Pwr Line  
S.15°W. - 5.33' - Set Tag above Fnd Spk W sd 10" R Pine  
S.67°W. - 3.0' - Rec J Pine (Now Stump)  
N.60°W. - 14.21' - Set Tag SW sd Tri Oak  
N.17°W. - 3.9' - Rec J Pine (Now Stump)

NOTE: Witness BTs were marked with Db1 Headed Nails with I.D. Cap #25852



Signed by Frederick J. King

Date 11-4-94

Surveyor's Michigan License No. 25852