

**SURVEY & REMONUMENTATION**

MAR 19 1997

COMMISSION

**LAND CORNER RECORDATION CERTIFICATE**  
Filing Requirement of Act 74, Mich. P.A. 1970

For corners in  
Oscoda \_\_\_\_\_ Located In: \_\_\_\_\_ Corner Code # \_\_\_\_\_  
(County)

1. Public Land Survey	T	<u>26N</u>	R	<u>2E</u>	<u>H - 1</u>
	T	_____	R	_____	_____
	T	_____	R	_____	_____
	T	_____	R	_____	_____
2. Property Controlling in Section	S	_____	T	_____	R
	S	_____	T	_____	R
3. Miscellaneous Property in Section	S	_____	T	_____	R
	S	_____	T	_____	R

4. Lot No. \_\_\_\_\_, Recorded Plat \_\_\_\_\_  
5. Private Claims \_\_\_\_\_

*Liber 4 pg 141*

STATE OF MICHIGAN  
OSCODA COUNTY  
FILED  
26 NOV 96 2:55 P.M.  
PATSY J. PETERS  
REGISTER OF DEEDS

Register of Deeds Stamp & File Number

A	B	C	D	E	F	G	H	I	J	K	L	M
2	6	5	4	3	2	1						
3												
4	7	8	9	10	11	12						
5												
6	18	17	16	15	14	13						
7												
8	19	20	21	22	23	24						
9												
10	30	29	28	27	26	25						
11												
12	31	32	33	34	35	36						
13												

I, Marvin E. Myers, in a field survey on June 28, 19 96, do hereby certify that under requirements of P.A. 74, Michigan P.A. of 1970, the corner points mentioned in lines 1 and 2 above were in conformance with regulations and rules therefore as required in the current manual of survey instructions of the United States Department of the Interior, Bureau of Land Management or by a decree of a Court of Law and/or that the corner points mentioned in lines 3, 4 and 5 above were in conformance with the rules of the Michigan Board of Professional Surveyors or by a Decree of a Court of Law; established, re-established, monumented, re-monumented, recovered, found as expressed below:

**NOTE:** Not more than 4 corners, all in the same town and range, may be recorded on this certificate.

**A. Description of original monument and accessories and/or subsequent restoration:**

Not a GLO Corner 1908 Fargo Eng. Mon.-1 3/4"x16" buried in corner	US GLO 1935 Guy Veal Mon.-Set 3 1/2" brass tablet in 6" conc. at proportionate distance standard corner West 0.085 chs. (5.61')	Liber 4, page 341 Nov. 1988 F. King Mon.-Fd. iron in mon. box 5.6' East of S 1/2 Cor. of S 1/2 Cor. Sec. 34
1932 possible Delamater Mon.-Fd. mon. left by Fargo survey G road intersection WIT: NBT iron Catg S45°W 46.7' iron Catg S45°E 45.0 buried	Liber 2, page 91 Apr. 1969 N. Caldwell Mon.-Fd. US GLO mon. raised with 1/2" bar flush with pavement WIT: corner fence post S43°W 43.5' corner fence post N38°W 44.2' S 1/2 Cor. Sec. 34, T27N, R2E 1s West 5.6'	


**B. Description of corner evidence found and/or method applied in restoring or reestablishing corner:**

Found 1/2" bar in pavement box  
Found standard corner East 5.32'  
This position not established by original government survey. This monument is accepted as a careful and faithful determination of the position of the corner.  
N 1/2 Cor. Sec. 3, T26N, R2E

**APPROVED**  
County Remonumentation  
Peer Review Group

*NCC  
16 Nov 96*

**C. Description of monument for corner and accessories established to perpetuate locating the position of the corner:**  
Monument - Replaced with a Standard Oscoda County Monument in Pav't box.  
WIT: Nail NW side utility pole S51°W 44.72'  
Nail NE side utility pole N48°W 75.88'  
Nail side utility pole N82°E 121.34'  
Top center concrete project marker N51°E 45.73'

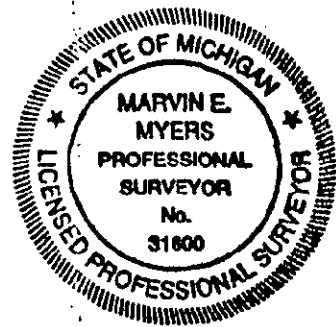

Signed by *Marvin E. Myers* Date September 7, 1996