SURVEY & REMONUMENTATION

APR 2 4 1995

COMMISSI	ON TAND CORN	ER RECORDATION CERTI	
For corners in	Filing Require	ement of Act 74, Mich. P.	A. 1970 (\
OSCODA	1	1	
(County)	Located in: BIG CREEK	Corner Code ≠#	STATE OF MICHIGAN
1 Public Land Comme			OSCODA COUNTY
Public Land Survey	T <u>26N</u> R <u>2E</u>	H-3	FILED
	T R T R		
	†R		15 NOV 94 11:10 A.M.
2. Property Controlling S	5 T R		DATOV I PETERS
	S T R		PATSY J. PETERS REGISTER OF DEEDS
	S T R		Register of Deeds Stamp & File Number
Property in Sec. S	S T R		3. store of books officially it is required
4. Lot No , Reco	orded Plat AP	PROVED	
5. Private Claims	County	Domonument	ABCDEFGHIJKLM
•	Poor	Pavious Commentation	0 2 5 4 4 3 2
	1 661	Review Group N	3
FREDERICK 3 VINC		-0	4 7 8 9 10 11 12
FREDERICK J. KING in to hereby certify that under required	a field survey on June 29	19. 94	5
n lines 1 and 2 above were in con	formance with regulations and	fittles therefore as required in	150 0 18-17-16-15-14-13-1
current manual of survey instruction	ns of the United States Denarti	ment of the Interior Bureau of L	ned 7
Management or by a decree of a Cou above were in conformance with the	or Law and/or that the corner Frules of the Michigan Board o	points mentioned in lines 3, 4 and Land Surveyors or by a Decree.	1d 5 8 19 20 21 22 23 24
court of Law; established, re-est	tablished, monumented, re-m	conumented, recovered, found	as 9
expressed below:			10 30 29 28 27 26 25
IOTE: Not more than 4 corne on this certificate.	rs, all in the same town an	d range, may be recorded	11
on this certificate.			12 31 32 33 34 35 36
. Description of original monu	ument and accessories and	/or subsequent restoration-	13
-3 1/4 CORNER COMMON TO SEC	CTIONS 3 & 10 (CORNE	R IN MIO POND - Ref Cor 2:	38.92' (3.62 Ch) W of True Cor)
July 1839 - Original Po			\$42W - Cedar - 3.30' (5 1ks)
OII (116 - F	ved or peeds		N11E - Hemlack - 7.921 (12 %be)
1935 - USGLO Mon S Prop Meas -	Set (Marked WC) by Guy R. - No Fyldence of Orig Co:	Veal, US Cad Eng - Set I	by East - W Shr Mio Pond -19.8'(0.3 CH)
,			Deeds S3½E - Poplar - 21.78' (33 lks) N54½W - Poplar - 29.04' (44 lks)
Apr 1964 - Cor used by	/ Norman C. Caldwell - No	Cor Description - No Wit	tnesses - Rec Rk T26N_D2F
Apr 1964 - Cor used by	/ Norman C. Caldwell - No	Cor Description - No Wid	noccoe Doe Di TOCH DOE
Apr 1964 - GLU Meander Rec Bk T26N	° Mon Fnd by Norman C. Ca N-R2F	ildwell, RLS - 238.9' W of	f True 1/4 Cor. No Witnesses
. Description of corner evider	NO AC	T 74 FND RECORDED FOR THE	S CORNER
Iron Alongsid	ie No 1839 Wit	' - W shore of Mio Pond (F	R-19.8° - 1935)
2,000	No 1935 Wit		
	2000 HT	, , , , w	
This Corner was Approve	d by the Oscoda County F	eer Review Committee as t	he Best available evidence of the
Re-Establishment of the	Original Corner on July	15. 1994.	~~~~ ~ • • • • • • • • • • • • • • • • • • •

Found Rec. USGLO Mon - $^{\pm}$ 16½' W of Shore of Mio Pönd


Iron Alongside

N25E - 8.93' - Set Tag in SE sd 6" Balsam

S55E - 8.13' - Set Tag in SW sd 4" Balsam S10W - 3.66' - Set Tag in E sd 5" Balsam S55W - 11.24' - Set Tag in N sd 6" Balsam

Set Treated 2"x4" along side.

NOTE: Witness 8Ts were marked with Db1 Headed Nails with I.D. Tag #25852

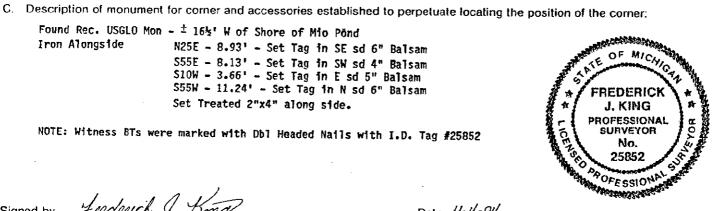

Signed by	Frederick	4	King
	Michigan License	V	' (/
Quiveyor 5	witchigan License	MO.	

__ Date <u>//- 4-94</u>