

**MYERS &
REMONUMENTATION**

MAR 19 1997

COMMISSION

**LAND CORNER RECORDATION CERTIFICATE
Filing Requirement of Act 74, Mich. P.A. 1970**

Liber 4 pg 143

STATE OF MICHIGAN
OSCODA COUNTY
FILED

26 NOV 96 2:58 P.M.

PATSY J. PETERS
REGISTER OF DEEDS

For corners in Oscoda (County)	Located In:	Corner Code #
1. Public Land Survey	T 26N R 2E	J - 1
	T _____ R _____	_____
	T _____ R _____	_____
	T _____ R _____	_____
2. Property Controlling in Section	S _____ T _____ R _____	_____
	S _____ T _____ R _____	_____
3. Miscellaneous Property in Section	S _____ T _____ R _____	_____
	S _____ T _____ R _____	_____

Register of Deeds Stamp & File Number

4. Lot No. _____, Recorded Plat _____
5. Private Claims _____

	A	B	C	D	E	F	G	H	I	J	K	L	M
2	6	5	4	3	2	1							
3													
4	7	8	9	10	11	12							
5													
6	18	17	16	15	14	13							
7													
8	19	20	21	22	23	24							
9													
10	30	29	28	27	26	25							
11													
12	31	32	33	34	35	36							
13													

I, Marvin E. Myers, in a field survey on June 29, 1996, do hereby certify that under requirements of P.A. 74, Michigan P.A. of 1970, the corner points mentioned in lines 1 and 2 above were in conformance with regulations and rules therefore as required in the current manual of survey instructions of the United States Department of the Interior, Bureau of Land Management or by a decree of a Court of Law and/or that the corner points mentioned in lines 3, 4 and 5 above were in conformance with the rules of the Michigan Board of Professional Surveyors or by a Decree of a Court of Law; established, re-established, monumented, re-monumented, recovered, found as expressed below:

NOTE: Not more than 4 corners, all in the same town and range, may be recorded on this certificate.

A. Description of original monument and accessories and/or subsequent restoration:

Not set by original survey
US GLO 1935 Guy Veal
Mon.-Set 3 1/4" Brass Tablet in
6" conc. mon. by proportionate
distance
WIT: 12" Poplar S39°E 113 lks.
10" Poplar S35 3/4°W 64 lks.

Sept. 1964 N. Caldwell
Mon-3/4" Pipe over US GLO
mon. flush with pav't
WIT: S 1/2 Cor. Sec. 35, T27, R2E
is 5.3' East

Liber 193, page 8278
Oct. 1993 T. Lapham
Mon.-Fd. 3/4" pipe in mon. box
WIT: Utility pole S45°W 44.48'
Light pole N15°W 28.02'
East 5.18' mon. box
Utility pole N60°W 85.34'

Nov. 1961 Norman Caldwell
Mon.-Fd. US GLO mon. raised to
surface with 1" pipe
Liber 2, page 89 Nov. 1961 N. Caldwell
Same as above

Liber 192, page 640 Nov. 1991
N. Caldwell
Mon.-Fd. 1" pipe in mon. box over
US GLO conc. mon.
WIT: East 5.3' S 1/2 Sec. 35
South 1304.2 N 1/8 N-S 1/2 line
West 2636.6' closing cor. 2 & 3
S45°W 46.8' 1/2" bar & cap #12018


B. Description of corner evidence found and/or method applied in restoring or reestablishing corner:
Found 3/4" pipe in monument box replaced pipe with standard Oscoda County Monument and cap
This position not established by original government survey.
This monument is accepted as a careful and faithful determination of the position of the corner.
Township corner T26N, R2E

APPROVED
County Remonumentation
Peer Review Group

*NCC
16 Nov 96*

C. Description of monument for corner and accessories established to perpetuate locating the position of the corner:

Replaced record 3/4" pipe with a Standard Oscoda County Monument
WIT: Nail NW side 7" Spruce S39°W 60.34'
Fd. spike in SW side Power Pole N57°W 85.34' (R)
Fd. spike NW side Light pole N12°W 28.02' (R)
Fd. spike in S. side Power pole N75°E 100.46' (R)

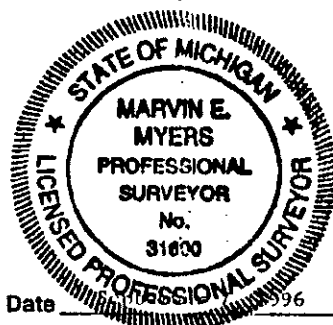

Signed by [Signature] Date _____

Surveyor's Michigan License No. 31600