

# SURVEY & REMONUMENTATION

APR 24 1995

COMMISSION

## LAND CORNER RECORDATION CERTIFICATE Filing Requirement of Act 74, Mich. P.A. 1970

Liber 4 Pg. 8

For corners in

Oscoda <small>(County)</small>	Located in: Big Creek Twp.	Corner Code -#  (J-7)
1. Public Land Survey	T <u>26N</u> R <u>2E</u>	_____
	T _____ R _____	_____
	T _____ R _____	_____
	T _____ R _____	_____
2. Property Controlling in Section	S _____ T _____ R _____	_____
	S _____ T _____ R _____	_____
3. Miscellaneous Property in Sec.	S _____ T _____ R _____	_____
	S _____ T _____ R _____	_____
4. Lot No. _____, Recorded Plat _____		
5. Private Claims _____		

STATE OF MICHIGAN  
OSCODA COUNTY  
FILED

3 NOV 94 9:34 A.M.

PATSY J. PETERS  
REGISTER OF DEEDS

**Register of Deeds Stamp & File Number**

I, Larry G. Beauregard in a field survey on July, 1994, do hereby certify that under requirements of P.A. 74, Michigan P.A. of 1970, the corner points mentioned in lines 1 and 2 above were in conformance with regulations and rules therefore as required in the current manual of survey instructions of the United States Department of the Interior, Bureau of Land Management or by a decree of a Court of Law and/or that the corner points mentioned in lines 3, 4 and 5 above were in conformance with the rules of the Michigan Board of Land Surveyors or by a Decree of a Court of Law; established, re-established, monumented, re-monumented, recovered, found as expressed below:

**NOTE: Not more than 4 corners, all in the same town and range, may be recorded on this certificate.**

	A	B	C	D	E	F	G	H	I	J	K	L	M
2	6	5	4	3	2	1							
3													
4	7	8	9	10	11	12							
5													
6	18	17	16	15	14	13							
7													
8	19	20	21	22	23	24							
9													
10	30	29	28	27	26	25							
11													
12	31	32	33	34	35	36							
13													

**A. Description of original monument and accessories and/or subsequent restoration:**

(J-7) Wood  $\frac{1}{4}$  section post set by William R. Coon in 1839.  
 Wits: 18" Y. Pine S 45° E 10 links 12" Y. Pine N 67° E 33 links  
 Clarence Seeley between 1910-1916 set  $\frac{1}{4}$  post, N.B.T. (W. Pine stump S 70° E 42 links)  
 Guy R. Veal in 1935 found no remaining evidence of original post or B.T.s. Set a brass tablet  $3\frac{1}{2}$ " diam., 3" stem in conc. mon. 24" long 6" diam., 18" in ground, with top marked Secs. 14 & 23. Government Deputy Surveyor. Dependent Resurvey of T26N, R2E. Wits marked: (8" J. Pine N 62° E 121 links) (6" J. Pine S 69° E 88 $\frac{1}{2}$  links).  
 Larry G. Beauregard P.S. #18654 in 1991 found U.S. GLO mon. in good condition. No 1935 wits. found. LCRC filed on 12-12-91. Wits marked: (6" J. Pine N 30° W 21.15'-Placed a nail & blaze) (3" W. Pine S 50° W 14.92'-Placed nail & blaze) (8" W. Pine S 45° W 41.03'-Placed nail & blaze) (12" W. Pine S 60° E 61.15'-Placed nail & blaze).


**B. Description of corner evidence found and/or method applied in restoring or reestablishing corner:**

(J-7) Found existing U.S. GLO mon. in good condition from 1935 Dependent Resurvey by Veal. 1935 wits. gone. Also placed  $\frac{1}{2}$ " bar alongside.

## APPROVED

County. Remonumentation  
Peer Review Group

NCC/31 OCT 94

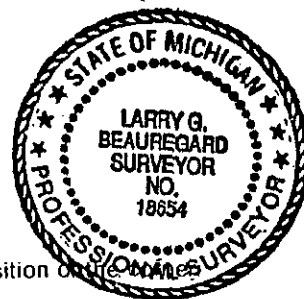

**C. Description of monument for corner and accessories established to perpetuate locating the position of the original corner:**  
 (J-7)  $\frac{1}{4}$  corner common to Secs. 14 & 23, T26N, R2E  
 U.S. GLO mon. in good condition from 1935 Dependent Resurvey by Veal, and is accepted as the best available evidence of the position of the original corner.

6" J. Pine N 35° W 21.15' (R)	4" W. Pine S 50° W 14.92'
12" W. Pine S 78° E 61.10'	12" W. Pine S 40° E 80.23'
12" W. Pine S 60° E 61.15'	8" W. Pine S 45° W 41.03'

Placed blaze, 20 penny spike and P.S. tag #18654 (typ).

Signed by Larry G. Beauregard Date 10/21/94  
 Surveyor's Michigan License No. 18654