SURVEY &
REMONUMENTATION

APR 2 4 1995

COMMISSION

LAND CORNER RECORDATION CERTIFICATE
Filing Requirement of Act 74, Mich. P.A. 1970

Liber 4 Pg. 20

For corners in

Oscoda
(County)

	Located In: Big Creek Twp.	Corner Code #
1. Public Land Survey	T 26N R 2E	(K-12)
	T ___ R ___	
	T ___ R ___	
	T ___ R ___	
2. Property Controlling	S ___ T ___ R ___	
in Section	S ___ T ___ R ___	
3. Miscellaneous	S ___ T ___ R ___	
Property in Sec.	S ___ T ___ R ___	

STATE OF MICHIGAN
OSCODA COUNTY
FILED

3 NOV 94 9:39 A.M.

PATSY J. PETERS
REGISTER OF DEEDS
Register of Deeds Stamp & File Number

4. Lot No. _____, Recorded Plat _____
5. Private Claims _____

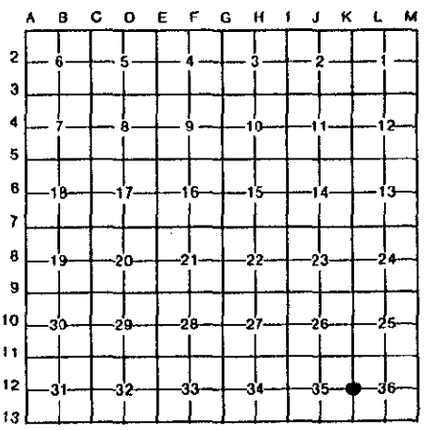

I, Larry G. Beauregard in a field survey on July, 19 94, do hereby certify that under requirements of P.A. 74, Michigan P.A. of 1970, the corner points mentioned in lines 1 and 2 above were in conformance with regulations and rules therefore as required in the current manual of survey instructions of the United States Department of the Interior, Bureau of Land Management or by a decree of a Court of Law and/or that the corner points mentioned in lines 3, 4 and 5 above were in conformance with the rules of the Michigan Board of Land Surveyors or by a Decree of a Court of Law; established, re-established, monumented, re-monumented, recovered, found as expressed below:

NOTE: Not more than 4 corners, all in the same town and range, may be recorded on this certificate.

A. Description of original monument and accessories and/or subsequent restoration:

(K-12) Wood $\frac{1}{4}$ section post set by William R. Coon in 1839.
Wits: 18" W. Pine S 70$\frac{1}{4}$° E 21 links 12" W. Pine N 7° W 15 links

Guy R. Veal in 1935 found the point for the $\frac{1}{4}$ section corner which is marked by an iron pipe, 1" x 6" above ground, properly set by a local surveyor at proportionate distance. Set a brass tablet 3" diam., 3" stem in conc. mon., 24" long, 6" diam., 18" in ground for the $\frac{1}{4}$ section corner with top marked Sections 35 and 36. Government Deputy Surveyor Dependent Resurvey of T 26 N, R 2 E. Corner falls at corner of fences bearing N & S, E & W. Field begins to West of line. Wits: (10" Norway Pine S 41° E 68 links) (7" W. Birch S 47-3/4° W 96$\frac{1}{2}$ links).

B. Description of corner evidence found and/or method applied in restoring or reestablishing corner:

(K-12) Found U.S. GLO mon. in good condition 6" above ground. Also found $\frac{1}{2}$" pipe on NE side of monument. Fence line N-S an West from corner.

APPROVED
County Remonumentation
Peer Review Group
NCL/31 OCT 94

STATE OF MICHIGAN
LARRY G. BEAUREGARD
SURVEYOR
NO. 18654
PROFESSIONAL SURVEYOR

C. Description of monument for corner and accessories established to perpetuate locating the position of the corner:

(K-12) $\frac{1}{4}$ corner common to Sections 35 & 36, T 26 N, R 2 E

U.S. GLO monument in good condition 6" above ground, $\frac{1}{2}$" pipe on NE side of monument, and is accepted as the best available evidence of the position of the original corner.

10" Elm N 28° E 32.04'
18" Norway S 45° E 44.88' (1935 witness)
12" Maple N 58° E 28.88'
24" W. Pine S 60° E 70.0'

Placed blaze, 20 penny spike & P.S. tag #18654 (typ)

Signed by Larry G Beauregard Date 10/21/94

Surveyor's Michigan License No. 18654

FORM APPROVED BY MICHIGAN STATE BOARD OF LAND SURVEYORS, JAN. 28, 1971
REVISED MAY 14, 1975
REVISED JAN., 1983