

SURVEY & REMONUMENTATION

APR 24 1995

COMMISSION

LAND CORNER RECORDATION CERTIFICATE
Filing Requirement of Act 74; Mich. P.A. 1970

Liber 4 Pg. 25

For corners in

Oscoda <small>(County)</small>	Located in: Big Creek Twp.	Corner Code -# (L-11)
1. Public Land Survey	T <u>26N</u> R <u>2E</u>	_____ (L-11)
	T _____ R _____	_____
	T _____ R _____	_____
	T _____ R _____	_____
2. Property Controlling in Section	S _____ T _____ R _____	_____
	S _____ T _____ R _____	_____
3. Miscellaneous Property in Sec.	S _____ T _____ R _____	_____
	S _____ T _____ R _____	_____
4. Lot No. _____, Recorded Plat _____		
5. Private Claims _____		

STATE OF MICHIGAN
OSCODA COUNTY
FILED

3 NOV 94 9:41 A.M.

PATSY J. PETERS
REGISTER OF DEEDS

Register of Deeds Stamp & File Number

I, Larry G. Beauregard in a field survey on June, 19 94, do hereby certify that under requirements of P.A. 74, Michigan P.A. of 1970, the corner points mentioned in lines 1 and 2 above were in conformance with regulations and rules therefore as required in the current manual of survey instructions of the United States Department of the Interior, Bureau of Land Management or by a decree of a Court of Law and/or that the corner points mentioned in lines 3, 4 and 5 above were in conformance with the rules of the Michigan Board of Land Surveyors or by a Decree of a Court of Law; established, re-established, monumented, re-monumented, recovered, found as expressed below:

NOTE: Not more than 4 corners, all in the same town and range, may be recorded on this certificate.

	A	B	C	D	E	F	G	H	I	J	K	L	M
2	6	5	4	3	2	1							
3													
4	7	8	9	10	11	12							
5													
6	18	17	16	15	14	13							
7													
8	19	20	21	22	23	24							
9													
10	30	29	28	27	26	25							
11													
12	31	32	33	34	35	36							
13													

A. Description of original monument and accessories and/or subsequent restoration:

(L-11) Wood $\frac{1}{4}$ section post set by William R. Coon in 1839.
 Wits: 18" Hemlock S 18° W 21 links 25" Hemlock N 38° E 16 links

Guy R. Veal in 1935 found the point for the $\frac{1}{4}$ section corner which is marked by an iron pipe 24" long, 2" diam., set 30" in ground, at intersection of roads bearing N, S, E and W. This point has been recognized by all interested parties as the true point for the $\frac{1}{4}$ section corner and the iron pipe is accepted as the best available evidence of the position of the original corner. Set a brass tablet $3\frac{1}{2}$ " diam., 3" stem in conc. mon. 24" long, 6" diam., 30" in the ground in road, for the $\frac{1}{4}$ section corner with top marked Secs. 25 & 36. Government Deputy Surveyor. Dependent Resurvey of T 26 N, R 2 E. Wits: (7" Elm S 70 $\frac{1}{2}$ ° E 140 links) (6" Elm N 75° W 325 $\frac{1}{2}$ links).

Norman C. Caldwell P.S. #12018 in 1973 found GLO mon. with brass cap raised with County corner. LCRC recorded L. 1, P. 108. Wits: (Conc. mon. N 45° E 46.4') (Fe. corner S 49° W 36.0') (P. Pole S 55° W 72.3') (P. Pole N 26° W 130.6').


B. Description of corner evidence found and/or method applied in restoring or reestablishing corner:

(L-11) Found standard Oscoda Co. corner over U.S. GLO mon. 6" below road running E. & N. & W. in C/L of road. (3" brass cap on a 1" x 3' pipe).

APPROVED

County Remonumentation
Peer Review Group

NCL/31 OCT 94

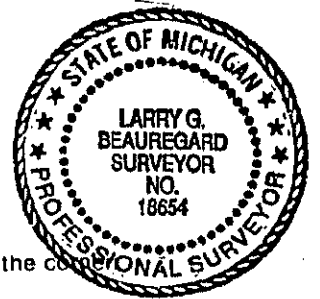

C. Description of monument for corner and accessories established to perpetuate locating the position of the corner:

(L-11) $\frac{1}{4}$ corner common to Sections 25 & 36, T 26 N, R 2 E

Found standard Oscoda Co. corner, 3" brass cap on a 1" x 3' pipe, over U.S. GLO monument 6" below road surface running E. & N. & W. in C/L of road, and is accepted as the best available evidence of the position of the original corner.

P. Pole S 50° W 72.75' P.K. nail & P.S. tag #18654. P. Pole N 25° W 130.83' P.K. nail & P.S. tag #18654.
 12" Norway S 35° E 68.98'
 13" W. Pine S 30° W 65.80'

Placed blaze, 20 penny spike & P.S. tag #18654 (typ)

Signed by Larry G. Beauregard Date 10/21/94
 Surveyor's Michigan License No. 18654