

LAND CORNER RECORDATION CERTIFICATE
Filing Requirement of Act 74, Mich. P.A. 1970

Liber 4 Pg. 106

For corners in <u>Oscoda</u> <small>(County)</small>	Located In:	Corner Code #
1. Public Land Survey	T <u>26 N</u> R <u>2 E</u>	<u>L-13</u>
	T _____ R _____	_____
	T _____ R _____	_____
	T _____ R _____	_____
2. Property Controlling in Section	S _____ T _____ R _____	_____
	S _____ T _____ R _____	_____
3. Miscellaneous Property in Section	S _____ T _____ R _____	_____
	S _____ T _____ R _____	_____

STATE OF MICHIGAN
 OSCODA COUNTY
 FILED
 19 SEP 95 4:05 P.M.
 PATSY J. PETERS
 REGISTER OF DEEDS

Register of Deeds Stamp & File Number

4. Lot No. _____, Recorded Plat _____
 5. Private Claims _____

A	B	C	D	E	F	G	H	I	J	K	L	M
2	6	5	4	3	2	1						
3												
4	7	8	9	10	11	12						
5												
6	18	17	16	15	14	13						
7												
8	19	20	21	22	23	24						
9												
10	30	29	28	27	26	25						
11												
12	31	32	33	34	35	36						
13												

I, Larry G. Beauregard, in a field survey on March 14, 19 95, do hereby certify that under requirements of P.A. 74, Michigan P.A. of 1970, the corner points mentioned in lines 1 and 2 above were in conformance with regulations and rules therefore as required in the current manual of survey instructions of the United States Department of the Interior, Bureau of Land Management or by a decree of a Court of Law and/or that the corner points mentioned in lines 3, 4 and 5 above were in conformance with the rules of the Michigan Board of Professional Surveyors or by a Decree of a Court of Law; established, re-established, monumented, re-monumented, recovered, found as expressed below:

NOTE: Not more than 4 corners, all in the same town and range, may be recorded on this certificate.

A. Description of original monument and accessories and/or subsequent restoration:


8-8-1838, Lewis Clason, Deputy Surveyor, set $\frac{1}{4}$ Section post. Witnesses marked: (N 54° E 20 links 12" Cedar) (N 69° W 24 links 12" Cedar).
 1924, Guy R. Veal, Dependent Resurvey, set iron post, 3' long, 1" diam., 27" in ground, for reestablished $\frac{1}{4}$ Section corner of Section 36. Witnesses marked: (N 43°-00' W 75 links 5" Poplar). No other bearing trees available, pits impracticable.
 5-23-1969, Norman C. Caldwell, P.S. #12018, found U.S. GLO monument, raised with 2" pipe by previous survey. No references available. (West 14.1' North $\frac{1}{4}$ Cor. Sec. 1). Recorded L. 2, P. 145, Oscoda Co. Records Corner Registry.
 11-5-1979, Norman C. Caldwell, P.S. #12018, boundary survey. Recorded L. 3, P. 241, Oscoda Co. Records. No references marked.

B. Description of corner evidence found and/or method applied in restoring or reestablishing corner:

Existing 2" pipe & cap set by Norman Caldwell in 1969 centerline of road, West 14.1' (R) 14.16' (M).
 Existing 2" pipe & cap North $\frac{1}{4}$ corner of Section 1, T 25 N, R 2 E.

APPROVED
 County Remonumentation
 Peer Review Group

NCC/16 SEPT 95

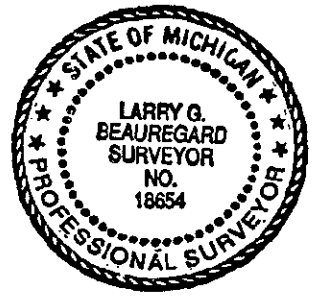

C. Description of monument for corner and accessories established to perpetuate locating the position of the corner:

South $\frac{1}{4}$ corner for Section 36, T 26 N, R 2 E
 Oscoda County Remonumentation cap P.S. #18654 on a 5/8" x 18" bar inside a 2" x 12" pipe, this all being inside a monument box. Accepted as a careful and faithful establishment of the position of the corner. Approved by the Peer Group on July 14, 1995.
 West 14.10' (R) 14.16' (M) Ex. 2" pipe & cap -N. $\frac{1}{4}$ corner Sec. 1, T 25 N, R 2 E
 South 33.08' USFS post & sign
 S 60° E 108.92' Power Pole - Placed P.K. nail & P.S. tag #18654
 S 35° E 83.33' 7" W. Pine - Placed 60d penny spike & P.S. tag #18654
 S 20° W 43.28' Power Pole - Placed P.K. nail & P.S. tag #18654
 S 05° W 51.68' NW cor. of lowest split stone on W. Pillar 3'x3'

Signed by Larry G. Beauregard Date 9/8/95
 Surveyor's Michigan License No. 18654