

LAND CORNER RECORDATION CERTIFICATE
Filing Requirement of Act 74, Mich. P.A. 1970

For corners in
OSCODA

Located In: _____ Corner Code *if* _____

- | | | | | | |
|------------------------------------|---|------------|---|-----------|-----------------|
| 1. Public Land Survey | T | <u>27N</u> | R | <u>1E</u> | <u>A-4, B-4</u> |
| | T | _____ | R | _____ | _____ |
| | T | _____ | R | _____ | _____ |
| | T | _____ | R | _____ | _____ |
| 2. Property Controlling in Section | S | _____ | T | _____ | _____ |
| | S | _____ | T | _____ | _____ |
| 3. Miscellaneous Property in Sec. | S | _____ | T | _____ | _____ |
| | S | _____ | T | _____ | _____ |

Register of Deeds Stamp & File Number

4. Lot No. _____, Recorded Plat _____
5. Private Claims _____

I, C.F. ROSER, in a field survey on SEPT., 19 89, do hereby certify that under requirements of P.A. 74, Michigan P.A. of 1970, the corner points mentioned in lines 1 and 2 above were in conformance with regulations and rules therefore as required in the current manual of survey instructions of the United States Department of the Interior, Bureau of Land Management or by a decree of a Court of Law and/or that the corner points mentioned in lines 3, 4 and 5 above were in conformance with the rules of the Michigan Board of Land Surveyors or by a Decree of a Court of Law; established, re-established, monumented, re-monumented, recovered, found as expressed below:

NOTE: Not more than 4 corners, all in the same town and range, may be recorded on this certificate.

	A	B	C	D	E	F	G	H	I	J	K	L	M
2	6	5	4	3	2	1							
3													
4	7	8	9	10	11	12							
5													
6	16	17	16	15	14	13							
7													
8	19	20	21	22	23	24							
9													
10	30	29	28	27	26	25							
11													
12	31	32	33	34	35	36							
13													


A. Description of original monument and accessories and/or subsequent restoration:
 A-4 _____ B-4 _____

B. Description of corner evidence found and/or method applied in restoring or reestablishing corner:
 A-4 _____ B-4 _____

SET CORNER MIDWAY BETWEEN SECTION CORNERS AND ON LINE. FOR 1/4 COR SEC. 7.	SET CORNER AT COMPUTED INTERSECTION OF 1/4 LINES FOR CENTER OF SEC. 7.
--	--

C. Description of monument for corner and accessories established to perpetuate locating the position of the corner:

A-4	B-4
SET D.N.R. MONUMENT	SET D.N.R. MONUMENT.
10" J.PINE N70°W 23.1'	NAIL & BRASS TAG
8" J.PINE N55°E 24.7'	6" J.PINE N33°E 55.6'
4" ASPEN S17°E 14.5'	6" J.PINE N80°E 39.5'
5" ASPEN S26°W 17.9'	6" CHERRY S23°E 66.4'
	4" J.PINE S36°W 18.5'

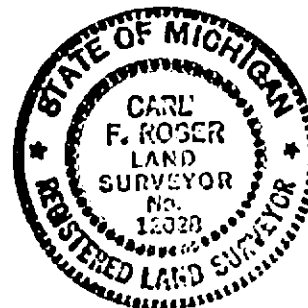

Signed by Carl F. Roser (Recorded 8-27-93) Date _____
 12028

Surveyor's Michigan License No. _____